

HOLMES

MISSISSIPPI BOARD OF WATER COMMISSIONERS


12-17-65

WATER WELL DRILLERS LOG CODED

Date: DEC 17, 1965, Driller: DELTA DRILLING Co. County: HOLMES

(Name)

	Description & Color of Materials Sand, Clay, Red Clay, Shell, etc.	Thick- ness Feet	Depth Feet
(1) Owner of Land: <u>N.W. YAWN</u> WELL LOCATION: <sup>(Name)</sup> <u>R.F. D., CRUGER</u> <u>GREENWOOD, MISS</u> <sub>(Address)</sub>	CLAY	55	55
	Sand	32	87
	gravel	48	135
(2) Location: <u>NE 1/4, SW 1/4, Sec. 17 T14R2E</u>	Clay	12	147
	Sand	60	207
<u>        </u> miles <u>        </u> of <u>        </u> <sub>(distance) (direction) (Nearest Town)</sub>	Clay	53	260
	Sand	53	313
(3) Topography: <u>        </u> <sub>(Hilly) (Flat) (Level)</sub>	Clay	62	375
(4) Purpose of Well: <u>DOMESTIC</u> <sub>(Domestic Irrigation Municipal, Industrial, Other)</sub>	Sand	12	387
	Shale CODED	9	396
	Sand	23	419
	Clay	20	439
	Sand	25	464
Information upon completion of well:			
(1) Diameter <u>4</u> inches.			
(2) Total Depth <u>538</u> feet.			
(3) Water Level <u>163'</u> feet below top of ground.			
(4) Cased to <u>454</u> , Size <u>4" - 284</u> <u>2" - 170</u>			
(5) Screen: Size <u>2"</u> , Length <u>10'</u>			
(6) Were any formations sealed against pollution? <u>        </u> yes, <u>        </u> no.			
If YES depth of formation <u>        </u>			
Why <u>        </u>			
Drillers Remarks: <u>210' PUMP SETTING</u> <u>WELL SET AT 464'</u>			

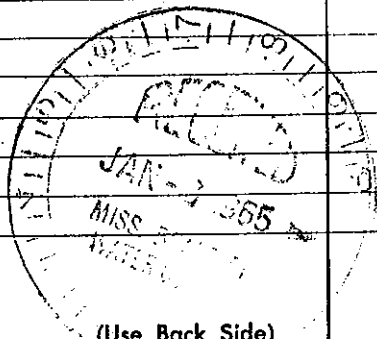

Well No.