

HOLMES
C9
4-61

MISSISSIPPI BOARD OF WATER COMMISSIONERS

WATER CODED WELL DRILLERS LOG

J 302


Date: April, 1961, Driller: Jack Martin County Holmes
(Name)

(1) Owner of Land:	Description & Color of Materials Sand, Clay, Red Clay, Shell, etc.	Thick- ness Feet	Depth Feet
<u>N. E. Diggs</u> (Name)	<u>Clay</u>	<u>34</u>	<u>34</u>
<u>Lexington Miss</u> (Address)	<u>Sand</u>	<u>20</u>	<u>54</u>
(2) Location: <u>SE 1/4, SW 1/4, Sec. 14 T. 16 R. 7 E</u>	<u>Sand & gravel</u>	<u>28</u>	<u>82</u>
<u>10</u> miles <u>North</u> of <u>Lexington</u> (distance) (direction) (Nearest Town)	<u>gravel</u>	<u>14</u>	<u>96</u>
(3) Topography: <u>Hilly</u> (Hilly) (Flat) (Level)	<u>Sand</u>	<u>61</u>	<u>157</u>
(4) Purpose of Well: <u>Domestic</u> (Domestic Irrigation Municipal, Industrial, Other)	CODED		

Information upon completion of well:

- (1) Diameter 2 inches.
- (2) Total Depth 153 feet.
- (3) Water Level 110 feet below top of ground.
- (4) Cased to 148, Size 2.
- (5) Screen: Size 2, Length 5.
- (6) Were any formations sealed against pollution?
_____ yes, _____ no.

If YES depth of formation _____
Why _____
Drillers Remarks: _____

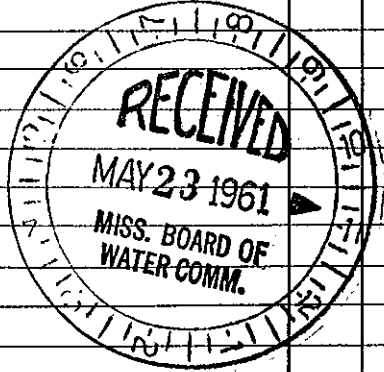

Well No.

(Use Back Side)