

HOLMES MISSISSIPPI BOARD OF WATER COMMISSIONERS

C11

WATER WELL DRILLERS LOG

CODED

C-300

Date: 10-60, 1960, Driller: Jack Martin County Holmes
 (Name)

(1) Owner of Land:	Description & Color of Materials Sand, Clay, Red Clay, Shell, etc.	Thick- ness Feet	Depth Feet
<u>Millie Wade</u> (Name)	<u>Red Clay</u>	<u>28</u>	<u>28</u>
<u>Lexington</u> (Address)	<u>Sand</u>	<u>1</u>	<u>29</u>
(2) Location: <u>SE 1/4, SW 1/4, Sec. 19 T16R27E</u>	<u>Rice clay</u>	<u>9</u>	<u>38</u>
<u>9</u> miles <u>East</u> of <u>Idubala</u>	<u>Sand</u>	<u>12</u>	<u>50</u>
(distance) (direction) (Nearest Town)	<u>Gravel + Sand</u>	<u>78</u>	<u>128</u>
(3) Topography: <u>Hilly</u>	<u>Sand</u>	<u>47</u>	<u>175</u>
(Hilly) (Flat) (Level)			
(4) Purpose of Well: <u>Domestic</u>			
(Domestic Irrigation Municipal, Industrial, Other)			

Information upon completion of well:


- (1) Diameter 2 inches.
- (2) Total Depth 173 feet.
- (3) Water Level 130 feet below top of ground.
- (4) Cased to 168, Size 2.
- (5) Screen: Size 2, Length 5'.
- (6) Were any formations sealed against pollution?
 _____ yes, no.

CODED

If YES depth of formation _____

Why _____

Drillers Remarks: _____

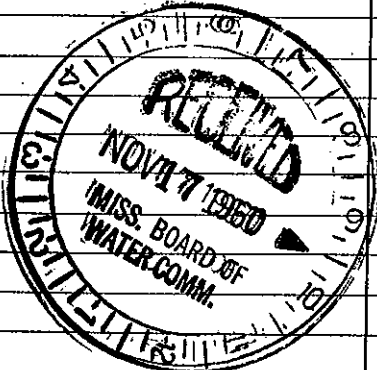

(Use Back Side)

Well No.

Mail this copy to Board of Water Commissioners 429 Miss. St. Jackson, Miss.