

HOLMES MISSISSIPPI BOARD OF WATER COMMISSIONERS

C12

1-3-62

WATER WELL DRILLERS LOG CODED

Date: 1-3, 1962, Driller: Jack Merton County Holmes  
 (Name)

(1) Owner of Land: <u>J. L. Bradlock</u> (Name)	Description & Color of Materials Sand, Clay, Red Clay, Shell, etc.	Thick- ness Feet	Depth Feet
<u>Lexington</u> (Address)	<u>Top clay</u>	<u>28</u>	<u>28</u>
(2) Location: <u>SW SE</u> <u>1/4, 1/4</u> , Sec. <u>13 T16R2E</u>	<u>Pipe clay</u>	<u>20</u>	<u>48</u>
<u>10</u> miles <u>North</u> , of <u>Lexington</u> (distance) (direction) (Nearest Town)	<u>Pipe clay - Sand streaks</u>	<u>30</u>	<u>74</u>
(3) Topography: <u>Hilly</u> (Hilly) (Flat) (Level)	<u>Sand</u>	<u>16</u>	<u>90</u>
(4) Purpose of Well: <u>Domestic</u> (Domestic Irrigation Municipal, Industrial, Other)	<u>Shovel - Sand</u>	<u>22</u>	<u>112</u>
	<u>Pipe clay - Sand streaks</u>	<u>6</u>	<u>118</u>
	<u>Sand</u>	<u>17</u>	<u>135</u>

CODED


Information upon completion of well:

- (1) Diameter 2 inches.
- (2) Total Depth 134 feet.
- (3) Water Level 110 feet below top of ground.
- (4) Cased to 129, Size 2.
- (5) Screen: Size 2, Length 5 ft.
- (6) Were any formations sealed against pollution?  
 yes,  no.

If YES depth of formation \_\_\_\_\_

Why \_\_\_\_\_

Drillers Remarks: \_\_\_\_\_

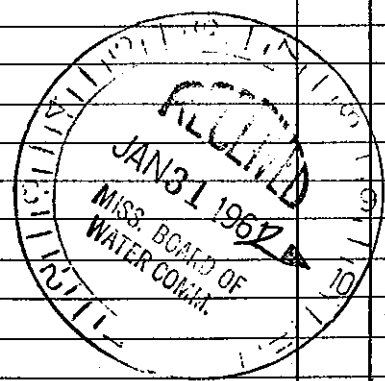

Well No.

(Use Back Side)

Mail this copy to Board of Water Commissioners 429 Miss. St. Jackson, Miss