

HOLMES
C13
11-63

MISSISSIPPI BOARD OF WATER COMMISSIONERS

WATER WELL DRILLERS LOG

CODED.

Date: Nov, 1963, Driller: Jack Martin County Holmes
(Name)

(1) Owner of Land: <u>H. E. Buck</u> (Name) <u>Lexington, Miss</u> (Address)	Description & Color of Materials Sand, Clay, Red Clay, Shell, etc.	Thick- ness Feet	Depth Feet
(2) Location: <u>SE 1/4, NW 1/4, Sec. 13, T16R22</u> <u>10</u> miles <u>N</u> , of <u>Lexington</u> (distance) (direction) (Nearest Town)	<u>Top clay</u>	<u>16</u>	<u>16</u>
(3) Topography: <u>Hilly</u> (Hilly) (Flat) (Level)	<u>Pipe clay</u>	<u>36</u>	<u>52</u>
(4) Purpose of Well: <u>Domestic</u> (Domestic Irrigation Municipal, Industrial, Other)	<u>Pipe clay + sand</u>	<u>12</u>	<u>64</u>
	<u>Sand</u>	<u>18</u>	<u>82</u>
	<u>Sand & Gravel</u>	<u>16</u>	<u>98</u>
	<u>Sand</u>	<u>14</u>	<u>112</u>
	<u>Sand & Gravel</u>	<u>7</u>	<u>119</u>
	<u>Sand</u>	<u>16</u>	<u>135</u>


Information upon completion of well:

- (1) Diameter 2 inches.
- (2) Total Depth 135 feet.
- (3) Water Level 115 feet below top of ground.
- (4) Cased to 129, Size 2.
- (5) Screen: Size 2, Length 5.
- (6) Were any formations sealed against pollution?
_____ yes, _____ no.

If YES depth of formation _____

Why _____

Drillers Remarks: _____

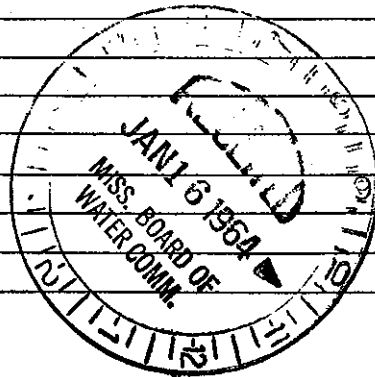

(Use Back Side)

Well No.

Mail this copy to Board of Water Commissioners 429 Miss. St. Jackson, Miss.