

HOLMES  
C15  
11-65

MISSISSIPPI BOARD OF WATER COMMISSIONERS

WATER WELL DRILLERS LOG CODED

Date: Nov, 1965, Driller: Jack Martin County Holmes  
(Name)

(1) Owner of Land: <u>Mrs. M. J. Evans</u> (Name)	Description & Color of Materials Sand, Clay, Red Clay, Shell, etc.	Thick- ness Feet	Depth Feet
<u>Lexington</u> (Address)	<u>clay</u>	<u>17</u>	<u>17</u>
(2) Location: <u>NW 1/4, SE 1/4, Sec. 36 T17R25</u>	<u>pipe clay</u>	<u>19</u>	<u>36</u>
<u>12</u> miles <u>N</u> , of <u>Lexington</u> (distance) (direction) (Nearest Town)	<u>Gravel Sand</u>	<u>112</u>	<u>148</u>
(3) Topography: <u>Willy</u> (Hilly) (Flat) (Level)			
(4) Purpose of Well: <u>Domestic</u> (Domestic Irrigation Municipal, Industrial, Other)			

Information upon completion of well:


CODED

- (1) Diameter 2 inches.
- (2) Total Depth 148 feet.
- (3) Water Level 121 feet below top of ground.
- (4) Cased to 143, Size 2.
- (5) Screen: Size 2, Length 5.
- (6) Were any formations sealed against pollution?  
\_\_\_\_\_ yes, \_\_\_\_\_ no.

If YES depth of formation \_\_\_\_\_

Why \_\_\_\_\_

Drillers Remarks: \_\_\_\_\_

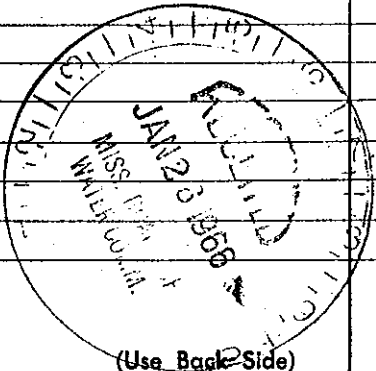

(Use Back Side)

Well No.