

HOLMES MISSISSIPPI BOARD OF WATER COMMISSIONERS

~~2-66~~ 2-66

WATER WELL DRILLERS LOG

CODED

Date: Feb, 1966, Driller: Jack Martin County: Saline

(Name)

(1) Owner of Land:	Description & Color of Materials Sand, Clay, Red Clay, Shell, etc.	Thick- ness Feet	Depth Feet
Walter Johnson (Name)	clay	21	21
Lexington (Address)	Sand	7	28
(2) Location: SW 1/4, NE 1/4, Sec. 36 T. 6 R. 2 E.	Mud	19	47
6 miles N, of Lexington (distance) (direction) (Nearest Town)	Sand	21	68
(3) Topography: Hilly (Hilly) (Flat) (Level)	CODED		
(4) Purpose of Well: Domestic (Domestic Irrigation Municipal, Industrial, Other)			


Information upon completion of well:

- (1) Diameter 2 inches.
- (2) Total Depth 68 feet.
- (3) Water Level 22 feet below top of ground.
- (4) Cased to 63, Size 2
- (5) Screen: Size 2, Length 5
- (6) Were any formations sealed against pollution?  
 yes,  no.

If YES depth of formation \_\_\_\_\_

Why \_\_\_\_\_

Drillers Remarks: \_\_\_\_\_

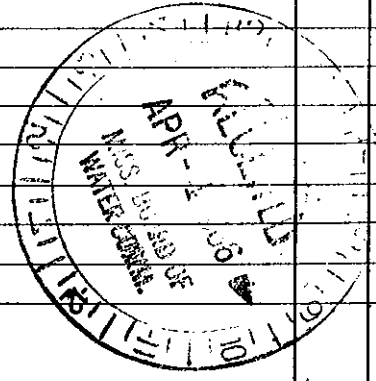

(Use Back Side)

Well No.