


HOLMES MISSISSIPPI BOARD OF WATER COMMISSIONERS

00C17
5-24-66

WATER WELL DRILLERS LOG CODED.

Date: 5-24, 1966, Driller: Smith Forge & Welding County Holmes
(Name)

	Description & Color of Materials Sand, Clay, Red Clay, Shell, etc.	Thick- ness Feet	Depth Feet
(1) Owner of Land: <u>H. B. Hart</u> (Name) <u>R. 3 Lexington Miss</u> (Address)	<u>yellow clay</u>	<u>54</u>	<u>54</u>
(2) Location: <u>NE 1/4, NE 1/4, Sec. 32 T16R2E,</u> <u>15</u> miles <u>NW</u> , of <u>Lexington</u> (distance) (direction) (Nearest Town)	<u>yellow sand</u> <u>Clay mixture</u> <u>hard pan</u>	<u>6</u> <u>1</u>	<u>60</u> <u>61</u>
(3) Topography: <u>Hilly</u> (Hilly) (Flat) (Level)	<u>Coarse yellow</u> <u>sand</u>	<u>7</u>	<u>68</u>
(4) Purpose of Well: <u>domestic</u> (Domestic Irrigation Municipal, Industrial, Other)	<u>gravel</u> <u>white sand</u>	<u>2</u> <u>10</u>	<u>70</u> <u>80</u>
CODED.			
Information upon completion of well:			
(1) Diameter <u>2</u> inches.			
(2) Total Depth <u>80</u> feet.			
(3) Water Level <u>40</u> feet below top of ground.			
(4) Cased to <u>74</u> , Size <u>2</u>			
(5) Screen: Size <u>1 1/4</u> , Length <u>5'</u>			
(6) Were any formations sealed against pollution? <u>no</u> , <input checked="" type="checkbox"/> yes, <input type="checkbox"/> no.			
If YES depth of formation _____			
Why _____			
Drillers Remarks: _____			

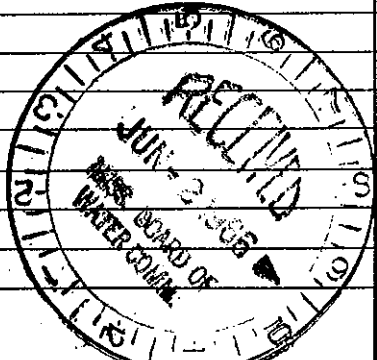

(Use Back Side)

12

Well No.

Mail this copy to Board of Water Commissioners 429 Miss. St. Jackson, Miss.