

Holmes
C 19
12-66

MISSISSIPPI BOARD OF WATER COMMISSIONERS

CODED

WATER WELL DRILLERS LOG

Date: Dec, 19 66, Driller: Jack Martin County Holmes
(When well drilled) (Name) (Where well is located)

| 1) Owner of Land: <u>J. D. Parrish Jr</u> <small>(Name)</small> | Description & Color of Materials Sand, Clay, Red Clay, Shell, etc. | Thick- ness Feet | Depth Feet |
|--|---|------------------------|---------------|
| <u>Ocean Springs Miss Box 137</u> <small>(Address)</small> | <u>Clay</u> | <u>35</u> | <u>35</u> |
| 2) Location: <u>SW 1/4, SW 1/4, Sec. 21 T16R2E</u> | <u>Pipe clay</u> | <u>6</u> | <u>41</u> |
| <u>8</u> miles <u>NW</u> of <u>Leighton</u> <small>(distance) (direction) (Nearest Town)</small> | <u>Gravel</u> | <u>7</u> | <u>48</u> |
| 3) Topography: <u>Hilly</u> <small>(Hilly) (Flat) (Level)</small> | <u>4" rock at 48 ft</u> | | |
| 4) Purpose of Well: <u>Domestic</u> <small>(Domestic Irrigation Municipal, Industrial, Other)</small> | <u>Mud</u> | <u>49</u> | <u>97</u> |
| | <u>Sand</u> | <u>13</u> | <u>110</u> |

Information upon completion of well:

(1) Diameter 2 inches.

(2) Total Depth 110 feet.

(3) Water Level 84 feet below top of ground.

(4) Cased to 105, Size 2

(5) Screen: Size 2, Length 5

(6) Were any formations sealed against pollution?
 _____ yes, no.

CODED

If YES depth of formation _____


Why _____

Drillers Remarks: _____

Yield in gpm: 3

Size pump: 1/2 H.P. Rod type pump

Type power: Electric

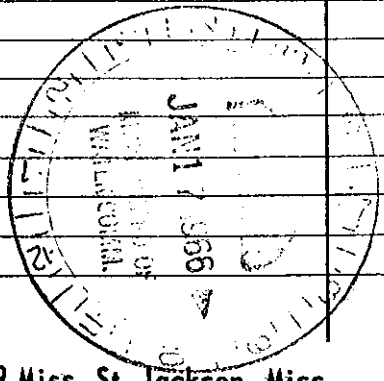

Mail this copy to Board of Water Commissioners 429 Miss. St. Jackson, Miss.