

HOLMES MISSISSIPPI BOARD OF WATER COMMISSIONERS

XC22
2-64

WATER WELL DRILLERS LOG

CODED

Date: Feb, 1964, Driller: Jack Martin County Holmes
(Name)

(1) Owner of Land:	Description & Color of Materials Sand, Clay, Red Clay, Shell, etc.	Thick- ness Feet	Depth Feet
(Name) E. W. Harker	Clay	26	26
(Address) Lexington	Sand	14	40
(2) Location: SW 1/4, SW 1/4, Sec. 36, T16N, R25E	Sand & Gravel	32	72
6 miles N of Lexington (distance) (direction) (Nearest Town)	Sand	17	89
(3) Topography: Hilly (Hilly) (Flat) (Level)			
(4) Purpose of Well: Domestic (Domestic Irrigation Municipal, Industrial, Other)			

CODED


Information upon completion of well:

- (1) Diameter 2 inches.
- (2) Total Depth 89 feet.
- (3) Water Level 70 feet below top of ground.
- (4) Cased to 84, Size 2
- (5) Screen: Size 2", Length 5'
- (6) Were any formations sealed against pollution?
_____ yes, _____ no.

If YES depth of formation _____

Why _____

Drillers Remarks: _____

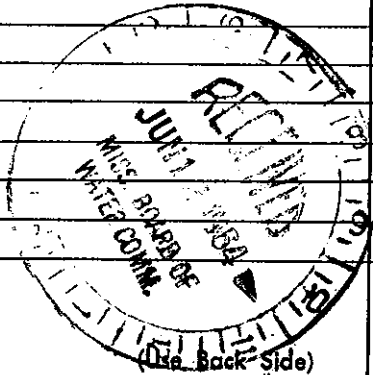

Well No. _____

Mail this copy to Board of Water Commissioners 429 Miss. St. Jackson, Miss