

HOLMES MISSISSIPPI BOARD OF WATER COMMISSIONERS

D12
5-23-66

WATER WELL DRILLERS LOG

CODED

Date: 5-23, 1966, Driller: Smith Forge & Welding County Holmes
(Name)

(1) Owner of Land: <u>Cyrus Montgomery</u> (Name)	Description & Color of Materials Sand, Clay, Red Clay, Shell, etc.	Thick- ness Feet	Depth Feet
<u>Selington Miss</u> (Address)	<u>yellow clay</u>	<u>20</u>	<u>20</u>
(2) Location: <u>W 2 1/4, E 2 1/4, Sec. 28 T16R38E</u>	<u>yellow sand</u>	<u>40</u>	<u>60</u>
<u>9</u> miles <u>north</u> of <u>Selington</u> (distance) (direction) (Nearest Town)	<u>hard sand rock</u>	<u>1</u>	<u>61</u>
(3) Topography: <u>Hilly</u> (Hilly) (Flat) (Level)	<u>yellow sand</u>	<u>40</u>	<u>101</u>
(4) Purpose of Well: <u>Domestic</u> (Domestic Irrigation Municipal, Industrial, Other)	<u>yellow sand</u>	<u>20</u>	<u>121</u>
	<u>clay mixture</u>		
	<u>white sand</u>		
	<u>with coal like</u>		
	<u>mixture</u>	<u>18</u>	<u>139</u>
	<u>white water</u>		
	<u>sand but fine</u>	<u>21</u>	<u>160</u>


Information upon completion of well:

- (1) Diameter 2 inches.
- (2) Total Depth 160 feet.
- (3) Water Level 100 feet below top of ground.
- (4) Cased to 156, Size 2
- (5) Screen: Size 1/4, Length 6'
- (6) Were any formations sealed against pollution?
 yes, no.

If YES depth of formation _____

Why _____

Drillers Remarks: _____

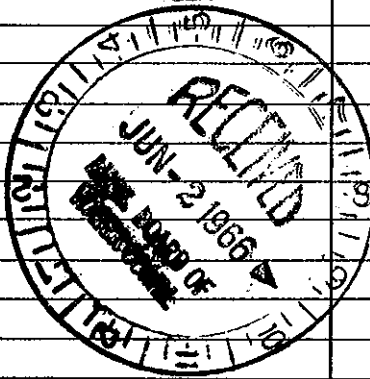

11

Well No.

(Use Back Side)

Mail this copy to Board of Water Commissioners 429 Miss. St. Jackson, Miss.