

Holmes
 D 13
 VZ-67

MISSISSIPPI
 BOARD OF WATER COMMISSIONERS
 416 North State Street
 Jackson, Mississippi 39201

CODED

WATER WELL DRILLERS LOG

Dec 19 1967 Jack Martin Holmes
 date well completed firm name county well located

LANDOWNER: C. H. Melton
 Durant
 Rt # 2
 (mailing address)


description of formations encountered	from	to
Clay	0	9
Sand	9	30
Sand + mud	30	56
Sand + pipe clay	56	105
Sand	105	164
Mud	164	172

WELL LOCATION:
 sec. 23 T 16 N R 3 E
 1.2 miles NE of Lexington
 (distance) (direction) (nearest town)

WELL PURPOSE: home
 (home, irrigation, municipal, industrial)

WELL COMPLETION DATA:
 (1) diameter (inches) 4" x 2"
 (2) total depth (feet) 604
 (3) static water level (feet) 205 below top of ground
 (4) casing Steel 589 (material) (depth)
 4 1/2" (size) If telescope see back.
 (5) screen 15 589 (length) (depth to top)
 2 Stainless Steel (size) (material)
 (6) pump 1 10 (HP) (yield gpm)
 Elec (type power)
 (7) electric log (yes or no)
 (organization running log)
 (8) how well bottom plugged Cap

CODED Sand	172	392
Mud	392	470
Sandy shale	470	540
rock at 348		
rock at 482		
Sand	540	604

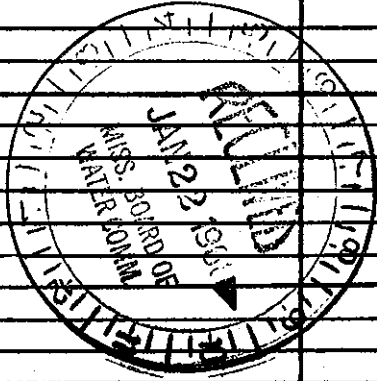

DRILLERS REMARKS: