

HOLMES

MISSISSIPPI BOARD OF WATER COMMISSIONERS

E 2

12-65

WATER WELL DRILLERS LOG CODED

Date: Dec, 19 65, Driller: Jack Martin County Holmes

(Name)

| (1) Owner of Land: <u>B. S. Ellis</u> | Description & Color of Materials Sand, Clay, Red Clay, Shell, etc. | Thick- ness Feet | Depth Feet |
|---|---|------------------------|---------------|
| (Name) | | | |
| <u>West</u> | <u>Clay</u> | <u>12</u> | <u>12</u> |
| (Address) <u>16N4E</u> | | | |
| (2) Location: <u>SE 1/4, SW 1/4, Sec. 28 T16R4E</u> | <u>pipe clay - sands</u> | <u>43</u> | <u>55</u> |
| <u>7</u> miles <u>W</u> , of <u>West</u> | <u>sand</u> | <u>18</u> | <u>73</u> |
| (distance) (direction) (Nearest Town) | | | |
| (3) Topography: <u>Hilly</u> | <u>rock</u> | <u>1</u> | <u>74</u> |
| (Hilly) (Flat) (Level) | | | |
| (4) Purpose of Well: <u>Domestic</u> | <u>Sand CODED</u> | <u>16</u> | <u>90</u> |
| (Domestic Irrigation Municipal, Industrial, Other) | | | |


Information upon completion of well:

- (1) Diameter 2 inches.
- (2) Total Depth 90 feet.
- (3) Water Level 74 feet below top of ground.
- (4) Cased to 85, Size 2
- (5) Screen: Size 2, Length 5
- (6) Were any formations sealed against pollution?
_____ yes, _____ no.

If YES depth of formation _____

Why _____

Drillers Remarks: _____

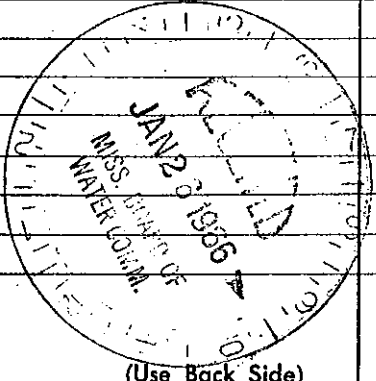

(Use Back Side)

Well No.