


**HOLMES** MISSISSIPPI BOARD OF WATER COMMISSIONERS  
**E4**  
**4-66** **WATER WELL DRILLERS LOG CODED**

Date: April, 1966, Driller: Jack Martin County Holmes  
 (Name)

(1) Owner of Land:	Description & Color of Materials Sand, Clay, Red Clay, Shell, etc.	Thick- ness Feet	Depth Feet
<u>Mrs. Grace Alexander</u> (Name)	<u>Clay</u>	<u>12</u>	<u>12</u>
<u>Diary 11111</u> (Address)	<u>Sand</u>	<u>16</u>	<u>28</u>
(2) Location: <u>SW 1/4</u> , <u>1/4</u> , Sec. <u>5 T16R4E</u>	<u>Sanded mud</u>	<u>36</u>	<u>64</u>
<u>1</u> miles <u>NW</u> , of <u>West</u> (distance) (direction) (Nearest Town)	<u>CODED</u>	<u>28</u>	<u>92</u>
(3) Topography: <u>Hilly</u> (Hilly) (Flat) (Level)			
(4) Purpose of Well: <u>Domestic</u> (Domestic Irrigation Municipal, Industrial, Other)			
Information upon completion of well:			
(1) Diameter <u>4</u> inches.			
(2) Total Depth <u>92</u> feet.			
(3) Water Level <u>70</u> feet below top of ground.			
(4) Cased to <u>85</u> , Size <u>4"</u>			
(5) Screen: Size <u>4"</u> , Length <u>7'</u>			
(6) Were any formations sealed against pollution?			
_____ yes, _____ no.			
If YES depth of formation _____			
Why _____			
Drillers Remarks: _____			
_____			
_____			
_____			

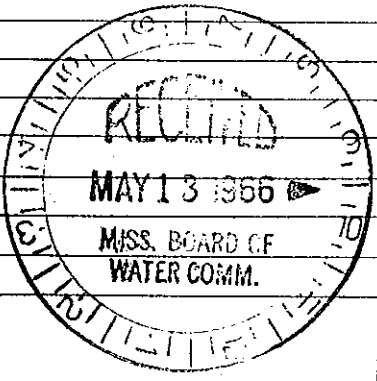

Well No.

(Use Back Side)

Mail this copy to Board of Water Commissioners 429 Miss. St. Jackson, Miss