

HOLMES MISSISSIPPI BOARD OF WATER COMMISSIONERS

E 5
4-12-66

WATER WELL DRILLERS LOG

CODED
CODED

Date: 4-12-66, 1966, Driller: Smith Forge & Welding County: Holmes
(Name)

(1) Owner of Land: Stene Maddox
(Name)
West Miss
(Address)

(2) Location: 2 1/2 1/4, 8 1/4 1/4, Sec. 24 T. 16 R. 4 E.
5 miles NW of West
(distance) (direction) (Nearest Town)

(3) Topography: Hilly
(Hilly) (Flat) (Level)

(4) Purpose of Well: Domestic
(Domestic Irrigation
Municipal, Industrial, Other)

Description & Color of Materials Sand, Clay, Red Clay, Shell, etc.	Thick- ness Feet	Depth Feet
red clay	6	6
red sand	14	20
sand rock	1	21
sand	9	30
black clay	6	36
hard rock	1	37
black clay	10	47
blue clay	29	76
blue clay mixture	12	88
CODED black clay	18	106
black mixture	14	120
black clay	20	140
hard rock	8"	
black clay	74	214
hard rock		
sees sand out	8	222
green sand	12	234
gray sand	59	293
sand mixture	22	315

Information upon completion of well:

(1) Diameter 2 inches.

(2) Total Depth 315 feet.

(3) Water Level 90 feet below top of ground.

(4) Cased to 273, Size _____

(5) Screen: Size 1/2, Length 0


(6) Were any formations sealed against pollution?
No yes, No no.

If YES depth of formation _____

Why _____

Drillers Remarks: sand to poor grade for sand screen

CODED

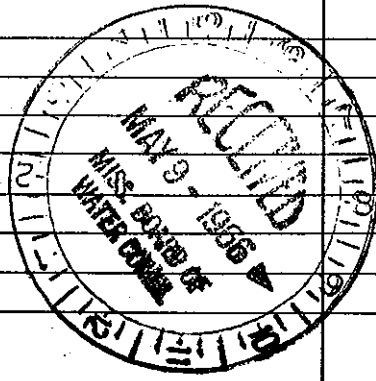

Well No. _____

(Use Back Side)

Mail this copy to Board of Water Commissioners 429 Miss. St. Jackson, Miss.