

HOLMES MISSISSIPPI BOARD OF WATER COMMISSIONERS

E 6
5-66

WATER WELL DRILLERS LOG

CODED

Date: May, 1966, Driller: Jack Martin County Holmes
(Name)

(1) Owner of Land: <u>J. H. Autrey</u> (Name)	Description & Color of Materials Sand, Clay, Red Clay, Shell, etc.	Thick- ness Feet	Depth Feet
<u>West</u> (Address)	<u>Clay</u>	<u>12</u>	<u>12</u>
(2) Location: <u>N.W. 1/4, D.W. 1/4, Sec. 33 T16R4E,</u> <u>8</u> miles <u>W</u> , of <u>West</u> (distance) (direction) (Nearest Town)	<u>4" rock at 12ft</u> <u>Sand</u>	<u>77</u>	<u>89</u>
(3) Topography: <u>Hilly</u> (Hilly) (Flat) (Level)			
(4) Purpose of Well: <u>Domestic</u> (Domestic Irrigation Municipal, Industrial, Other)			

CODED


Information upon completion of well:

- (1) Diameter 2 inches.
- (2) Total Depth 89 feet.
- (3) Water Level 68 feet below top of ground.
- (4) Cased to 84, Size 2
- (5) Screen: Size 2, Length 5
- (6) Were any formations sealed against pollution?
_____ yes, _____ no.

If YES depth of formation _____

Why _____

Drillers Remarks: _____

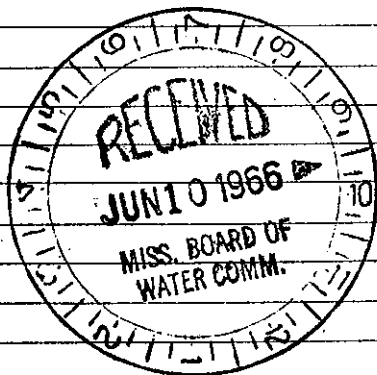

Well No.

(Use Back Side)

Mail this copy to Board of Water Commissioners 429 Miss. St. Jackson, Miss