


Holmes
E 7
11-66

MISSISSIPPI
BOARD OF WATER COMMISSIONERS CODED

WATER WELL DRILLERS LOG

11-25-1966 date well completed
Smith Forge & Welding firm name
Holmes county well located

LANDOWNER: John Halls	description of formations encountered	thick-ness feet	depth feet
TR 1 Box 80			
West Miss (mailing address)	red clay	19	19
WELL LOCATION: sec 28 T 16 N R 4 E 7 1/2 miles west of west (distance) (direction) (nearest town)	Red clay	16	35
WELL PURPOSE: Home (home, irrigation, municipal, industrial)	red sand	1	36
WELL COMPLETION DATA:	sand rock		
(1) diameter (inches) 2	gray sand clay	29	65
(2) total depth (feet) 100	mixture	5	70
(3) static water level (feet) 75 below above top of ground.	red sand	1	71
(4) casing 9" Pipe X 1494 (material) (depth) 2 X 1/4 (size) If telescope see back.	sand rock	11	82
(5) screen brass mesh (material) (depth to top) 1/4, 6' (size) (length)	gray coarse sand	1	83
(6) pump (HP) (yield gpm) (type power)	other layers of gray clay		
(7) electric log no (yes or no)	white & coarse sand	17	100
(organization running log)	CODED		

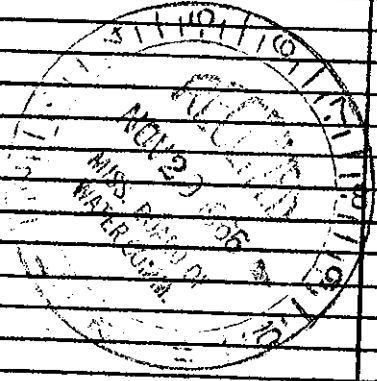

DRILLERS REMARKS: No pumps have been ins. I recommend 1-HP multi stage jet pump