State V	Vell Report
County: Hoimes Permit #: <u>+ '' well</u> Mississippi Departmen Office of Land	Part 1 th of Environmental Quality and Water Resources Box 10631 For Office Use Only: Aquifer: Well #:
Date drilling completed: <u>8-16-04</u> (601)	1S 39289-0631 L. S. Elevation: 961-5210 E-iog #:
State Law requires that this report be prepared by the 30 days of completion of drilling of the well.	driller in detail and filed with the Department within
Well Owner Information	Well Location
Owner Name DON WYNNE	Latitude: <u>33 • 13 • 37</u> " Longitude: <u>89 • 55 • 21</u>
Mailing Address: 416 Dogwood PI	Method of Lat/Long (circle one): Conventional Survey,
Brandon Ms 39043	USGS quad, Hand-held GPS, Survey-grade GPS NW 14 NE 14 Sec 19 OK 16 N Rng 4 E
City State Zip Code Telephone No. (601) $919 - 0701$	Distance Direction Nearest Town MS
Well I	
Purpose of Well (circle one) Home Industrial Public Supply	Irrigation Fish Culture Other:
Date well drilling started: $8 - 3 - 04$ Date	vell drilling completed: $8 - 16 - 09$
If flowing, method of flow regulation: Valve Other (det	escribe)
Static Water Level: <u>105</u> feet above or below (circle one) l	and surface Date measured: 8 - 11-04
Method of Measurement (circle one) steel tape electric tape	> air line other:
Hole depth: <u>310</u> Well depth: <u>260</u>	Well grouted to a depth of
Type of grout (circle one): Cement Bentonite Mix Casing length: <u>220</u> feet Casing diameter: <u>4</u>	A
Screen length; <u>40</u> feet Screen diameter: <u>4</u>	
Screen slot size: 0.08 inches Setting depth: From_	feet tofeet
Type of completion (circle all applicable): Gravel packed Under	eamed Telescoped Open hole Natural Development
Other (describe):	
Top of lap pipe or reduction in casing:feet. If tel	escoped or more than one screen, describe on back of page
Logs run (circle all applicable). No log run Electric Gamma Ray	Density Sonic Neutron Other:
Name of organization running log(s):	
I certify that the well was drilled, constructed, and completed in a	cordance with all applicable requirements of the Mississipp
Department of Environmental Quality and/or the Mississippi Depa	artment of Health regulations and state laws.
AINOID FINCHArST 0598	Wred Hunch Sr
Print Name of Water Well Contractor and License No.	Signature Ler Ver Verschr
	AUG 2 3 2004
	BY: OLWR



If well telescopes please sketch below and show depths.



Level	Description of Formations Encountered	From	Ta
	Surface Loam Sanda Red Clay	0	To 30
	Sanda Red Cluy	30	
	Sand	65	310
		+	44
		+	4
		+	<u>+</u>
		+]
			┢┤
		+	╂{
		1	
		<u> </u>	ļļ
		<u>+</u>	<u> </u>
		<u> </u>	
		├ ── ─┤	


If more than one screen, show location of each on sketch

Sketch the property layout and include the following: 1) the well location; 2) any permanent structures on the property that may aid in locating the well; 3) any roads, power lines, or other items that may aid in locating the property and the well; 4) indicate direction.

Pilgram Church Rd Pilgram Church Rd Her Gate Thuse Well WINNE Landowner Name:

Signature of Water Well Contractor

RECEIVED AUG 2 3 2004 BY: OLWR

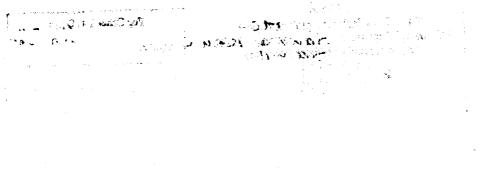

. . باله از <u>الدولة و</u>مكنديتين مايشتان مراق ومسم ميزين المقطر المرور المرور المرو

*•••



का मुल्ला स्टर्भ अदली e - Claro Ref.

parente de



. نې بو 1

2

---(1, 2).

τ. .

143 A.S. TRX -***** 1. 24

.

4

· · · · · · · · · · · · · · · · · · ·		STATE	WELL REPORT	I.
County: Hell	mes		Part 2	For Office Use Only
Permit #: 4/1	will	inississippi Depar	Pump Installer's Completion Report Mississippi Department of Environmental Quality Office of Land and Water Resources P.O. Box 10631 Jackson, MS 39289-0631	
	H Finchers	Р		
Date completed:	5-16-04		601)961-5210	Well #:8
(601): This report should be prepared by the pump installer in det installation of pump.		1)354-6938 (fax)	Elevation:	
installation o	f pump. Well Owner Inform	the partic histaner in a	etail and filed with the Dep	partment within 30 days of the
Owner Name: Don Wynne Mailing Address: 416 Deginood Pl			Well Location	
Mailing Address	416 Dogu	e Pl	f.	Longitude:
Annual Mudicos.	tie define	00 11	Method of Lat/Long (ci	rcle one): Conventional Survey,
-	Brandon M	2013	USGS quad,	Hand-held GPS, Survey-grade GP.
	City State	Zip Code	¼ ¼ Se	ec_19_Twn_16N Rng 4 E
	al QIG	•		tion Nearest Town
Telephone No. (01,919-0	201	<u>10</u> _Miles _W/	Not west, MS
	Pump Type			Power Type
() X	Circle one			Circle one
Air Lift	Jet	Submersible	Diesel Engine G	asoline Engine Natural Ga
Bucket	Piston	Turbine	Electric Motor H	land Tractor PT(
Centrifugal	Rotary	Flowing Well	Windmill O	Other (specify):
Other (specify):			Horse Power Rating of M	
	8-14-		Setting Depth: 2	CO feet
Rated Pump Capacit	<u>y: 80</u>	Gallons Per Minute	Number of Stages:	
	Pump Test Data		Mathedad	P Maaaaa ka k
Date Well Tested:	3-14-0	4	Intection of	f Measuring Water Level Circle one
Static Water Level (A	A): 105 Feet H	Below Land Surface	Air Line Electric	Measuring Line Steel Tape
	1 (B): 126 Feet B		Other (specify):	
Drawdown [(B) – (A)	71	Below Land Surface	Ron flouring a str	
Test Pumping Rate: _	110			d shut in head:feet
		Gallons Per Minute		OPM with a drawdown of
- auton of rump Tes	st (minimum 4 hours): _	hours	feet afte	erhours of pumping
HERERY CERTEN	that the share			A
inal to	that the above stateme	0598	f my knowledge.	Junch S
Print Name of Pump I	nstaller and License No	. (if applicable)	Signature of Pump	
,, /				
				AUG 2 3 2004
				BY: OLWR