

Holmes  
 71  
 6-1968  
 June 1968  
 date well completed

MISSISSIPPI  
 BOARD OF WATER COMMISSIONERS  
 416 North State Street  
 Jackson, Mississippi 39201

WATER WELL DRILLERS LOG  
 Robert E. Kately Co. Holmes  
 firm name county well located


LANDOWNER: Leon & West, Miss.

description of formations encountered	from	to
Clay Shale Rock	1	50
Shale + Sand	50	110
S. shale	110	160
Sand	160	220
Sand + clay	220	310
Shale	310	380
Sand	380	410
Shale	410	615
Sand	615	650
Shale	650	775
Rock	775	780
Shale	780	990
Rock	990	995
Shale	995	1130
Sand	1030	1050
Shale	1050	1250
Sand	1250	1340

(mailing address)  
 WELL LOCATION:  
 sec. 3 T 15N R 5E  
 S W  
 In Leon  
 (distance) (direction) (nearest town)

WELL PURPOSE: Municipal  
 (home, irrigation, municipal, industrial)

WELL COMPLETION DATA:  
 (1) diameter (inches) 6 x 4  
 (2) total depth (feet) 1340  
 (3) static water level (feet) flow below top of ground  
 (4) casing Bl. St. (material) 1250 (depth)  
6" (size) if telescope see back.  
 (5) screen 60 (length) 1250 (depth to top)  
4" (size) st. st. (material)  
 (6) pump 10 (HP) (yield gpm)  
electric (type power)  
 (7) electric log yes (yes or no)  
M.G. Survey (organization running log)  
 (8) how well bottom plugged BPO

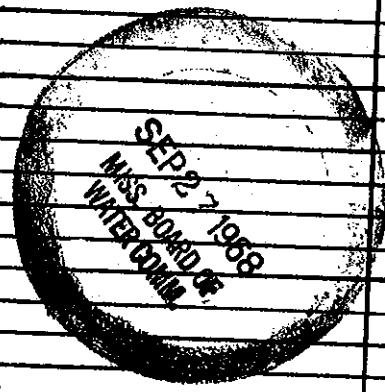

DRILLERS REMARKS: 30 feet of blank pipe between screens