

HOLMES

MISSISSIPPI BOARD OF W.

COMMISSIONERS

F 19

8-14-62

WATER WELL DRILLERS LOG CODED


Date: 8-14, 1962, Driller: Smith Presley County Holmes

		Description & Color of Materials Sand, Clay, Red Clay, Shell, etc.	Thick- ness Feet	Depth Feet
(1) Owner of Land: <u>Joe Nathan Cain</u> (Name)		Yellow Clay	4	4
<u>PO Box 63 West Miss</u> (Address)		Yellow Sand	6	10
(2) Location: <u>SW 1/4</u> , <u>1/4</u> , Sec. <u>34</u> T. <u>16R</u> S. <u>6E</u>		yellow clay with white clay mixture	9	19
<u>1/4</u> miles <u>North</u> , of <u>West</u> (distance) (direction) (Nearest Town)		near white clay black clay	5 20	24 44
(3) Topography: <u>flat</u> (Hilly) (Flat) (Level)		gray rock about black clay	6" 3	47
(4) Purpose of Well: <u>Domestic</u> (Domestic Irrigation Municipal, Industrial, Other)		thin rock black clay silt mixture green	28	75

Information upon completion of well:

- (1) Diameter 2" inches.
- (2) Total Depth 114 feet.
- (3) Water level 8 feet below top of ground.
- (4) Cased to 105, Size 2"
- (5) Screen: Size 1/4", Length 6'
- (6) Were any formations sealed against pollution?
yes, no no.

Description & Color of Materials Sand, Clay, Red Clay, Shell, etc.	Thick- ness Feet	Depth Feet
Yellow Clay	4	4
Yellow Sand	6	10
yellow clay with white clay mixture	9	19
near white clay black clay	5 20	24 44
gray rock about black clay	6" 3	47
thin rock black clay silt mixture green	28	75
green gray sand black mixture also shell mixture	28	95
rock	3"	
sand black mixture shells	8	103
white sand silt mixture of shell	8	111

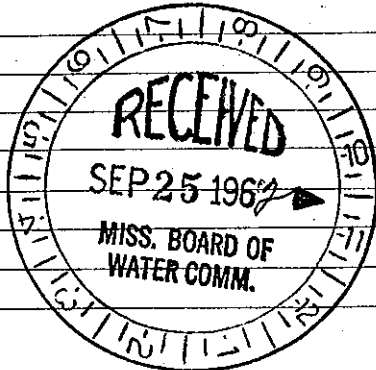

(Use Back Side)

32

Well No.