

HOLMES MISSISSIPPI BOARD OF WATER COMMISSIONERS

CODED


F23

1-64

WATER WELL DRILLERS LOG

Date: Dec, 1964, Driller: Jack Martin County Holmes
(Name)

| | Description & Color of Materials Sand, Clay, Red Clay, Shell, etc. | Thick- ness Feet | Depth Feet |
|--|---|------------------------|---------------|
| (1) Owner of Land: <u>A. P. Carroll</u> <small>(Name)</small> <u>Lexington</u> <small>(Address)</small> | Clay | 16 | 16 |
| (2) Location: <u>SW 1/4, NE 1/4, Sec. 27 T. 16 R. 5 E.</u> <u>1</u> miles <u>North</u> of <u>West</u> <small>(distance) (direction) (Nearest Town)</small> | Pipe clay | 8 | 24 |
| (3) Topography: <u>Flat</u> <small>(Hilly) (Flat) (Level)</small> | Sand | 5 | 29 |
| (4) Purpose of Well: <u>Domestic</u> <small>(Domestic Irrigation Municipal, Industrial, Other)</small> | Black mud | 4 | 33 |
| Information upon completion of well: | Little Sand - mud | 39 | 72 |
| (1) Diameter <u>2</u> inches. | 2" rocks at 35 + at 72 | | |
| (2) Total Depth <u>199</u> feet. | Mud | 86 | 158 |
| (3) Water Level <u>13</u> feet below top of ground. | CODED | 41 | 199 |
| (4) Cased to <u>189</u> , Size <u>2</u> | | | |
| (5) Screen: Size <u>2</u> , Length <u>10</u> | | | |
| (6) Were any formations sealed against pollution? _____ yes, _____ no. | | | |
| If YES depth of formation _____ | | | |
| Why _____ | | | |
| Drillers Remarks: _____ | | | |
| | | | |
| | | | |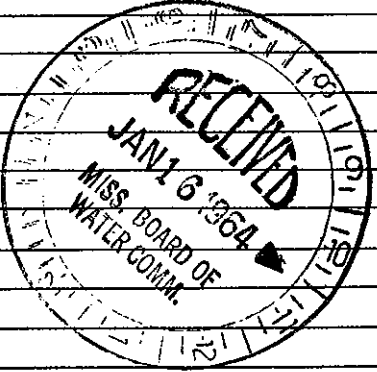
(Use Back Side)

Well No.

Mail this copy to Board of Water Commissioners 429 Miss. St. Jackson, Miss.