

HOLMES MISSISSIPPI BOARD OF WATER COMMISSIONERS

F29

5-64

WATER WELL DRILLERS LOG

Date: May, 1964, Driller: Jack Martin (Name) Holmes (County) **CODED**

(1) Owner of Land: <u>Mrs Della Melton</u> <small>(Name)</small>	Description & Color of Materials Sand, Clay, Red Clay, Shell, etc.	Thick- ness Feet	Depth Feet
<u>Durant</u> <small>(Address)</small>	<u>Clay</u>	<u>14</u>	<u>14</u>
(2) Location: <u>NE 1/4, SE 1/4, Sec. 30 T5R5E</u>	<u>Sand &amp; Mud</u>	<u>14</u>	<u>28</u>
<u>4</u> miles <u>North</u> , of <u>Durant</u> <small>(distance) (direction) (Nearest Town)</small>	<u>Sand</u>	<u>13</u>	<u>41</u>
(3) Topography: <u>Hilly</u> <small>(Hilly) (Flat) (Level)</small>			
(4) Purpose of Well: <u>Domestic</u> <small>(Domestic Irrigation Municipal, Industrial, Other)</small>			

Information upon completion of well:


- (1) Diameter 2 inches.
- (2) Total Depth 41 feet.
- (3) Water Level 21 feet below top of ground.
- (4) Cased to 36, Size 2
- (5) Screen: Size 2, Length 5
- (6) Were any formations sealed against pollution?  
\_\_\_\_\_ yes, \_\_\_\_\_ no.

If YES depth of formation \_\_\_\_\_

Why \_\_\_\_\_

Drillers Remarks: \_\_\_\_\_

**CODED**

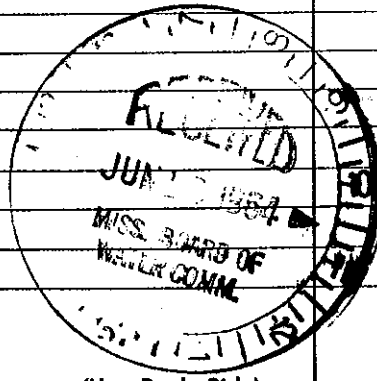

(Use Back Side)

Well No.

Mail this copy to Board of Water Commissioners 429 Miss. St. Jackson, Miss