

HOLMES
F 26
6-65


MISSISSIPPI BOARD OF WATER COMMISSIONERS

CODED

WATER WELL DRILLERS LOG

Date: June, 1965, Driller: Jack Martin County Holmes
(Name)

(1) Owner of Land:	Description & Color of Materials Sand, Clay, Red Clay, Shell, etc.	Thick- ness Feet	Depth Feet
<u>J. W. Guess</u> (Name)	<u>Clay</u>	<u>8</u>	<u>8</u>
<u>Durant</u> (Address)			
(2) Location: <u>SW 1/4, NE 1/4, Sec. 20 T14R5E</u>	<u>Pipe clay - sand</u>	<u>7</u>	<u>15</u>
<u>5</u> miles <u>NE</u> of <u>Durant</u>	<u>Pipe clay</u>	<u>2</u>	<u>17</u>
(distance) (direction) (Nearest Town)			
(3) Topography: <u>Flat</u>	<u>Mud</u>	<u>119</u>	<u>136</u>
(Hilly) (Flat) (Level)	<u>Rock at 115 & 119</u>		
(4) Purpose of Well: <u>Domestic</u>	<u>Shell - shale</u>	<u>8</u>	<u>144</u>
(Domestic Irrigation Municipal, Industrial, Other)	<u>Green Sand</u>	<u>50</u>	<u>194</u>
Information upon completion of well:			
(1) Diameter <u>4 1/2</u> inches.	<u>Shale</u>	<u>3</u>	<u>197</u>
(2) Total Depth <u>364</u> feet.			
(3) Water Level <u>4</u> feet <u>above</u> top of ground.	<u>Sand</u>	<u>37</u>	<u>234</u>
(4) Cased to <u>349</u> , Size <u>4" / 2"</u>	<u>Mud + Sand</u>	<u>32</u>	<u>266</u>
(5) Screen: Size <u>2</u> , Length <u>15'</u>	<u>Sand</u>	<u>26</u>	<u>292</u>
(6) Were any formations sealed against pollution?	<u>Mud</u>	<u>12</u>	<u>304</u>
_____ yes, _____ no.	<u>Sand - shale - rocks</u>	<u>32</u>	<u>336</u>
If YES depth of formation _____	<u>Sand</u>	<u>28</u>	<u>364</u>
Why _____			
Drillers Remarks: _____			

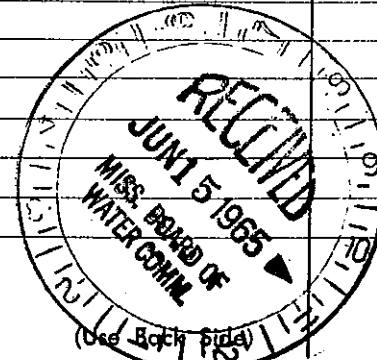

Well No.

Mail this copy to Board of Water Commissioners 429 Miss. St. Jackson, Miss.