

HOLMES
F27
6-65

MISSISSIPPI BOARD OF WATER COMMISSIONERS

WATER WELL DRILLERS LOG CODED

Date: June, 1965, Driller: Jack Martin County Holmes
(Name)

(1) Owner of Land: J.W. Green
(Name)
Durant
(Address)

(2) Location: NW 1/4, NW 1/4, Sec. 29 T15R5E
4 miles NE, of Durant,
(distance) (direction) (Nearest Town)

(3) Topography: Flat
(Hilly) (Flat) (Level)

(4) Purpose of Well: Domestic
(Domestic Irrigation, Municipal, Industrial, Other)

Description & Color of Materials Sand, Clay, Red Clay, Shell, etc.	Thick- ness Feet	Depth Feet
Clay	15	15
Pipe clay	4	19
Sand	12	31
Mud	30	61
Sand - mud streaks	16	77
Mud	108	185
Rock at 98-140-142		
Sand	80	265
Mud	32	297
Sand - mud streaks	18	315
Brown sand	6	321
Sand - shale - rock layers	36	357
Sand	53	410

Information upon completion of well:

(1) Diameter 2 inches.

(2) Total Depth 410 feet.

(3) Water Level 1 feet above below top of ground.

(4) Cased to 400, Size 2


(5) Screen: Size 2, Length 10

(6) Were any formations sealed against pollution?
_____ yes, _____ no.

If YES depth of formation _____

Why _____

Drillers Remarks: _____

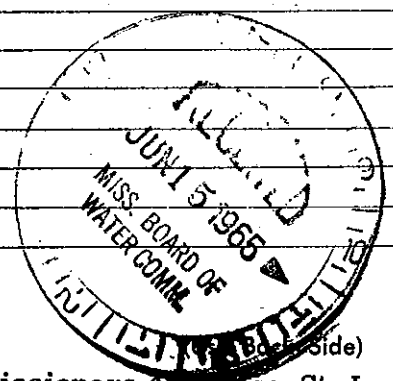

Well No. _____

Mail this copy to Board of Water Commissioners 407 Miss. St. Jackson, Miss