

HOLMES
F 32
6-66

MISSISSIPPI BOARD OF WATER COMMISSIONERS

WATER WELL DRILLERS LOG

CODED


Date: June, 1966, Driller: Jack Martin County Harrison
(Name)

(1) Owner of Land:	Description & Color of Materials Sand, Clay, Red Clay, Shell, etc.	Thick- ness Feet	Depth Feet
<u>M. Bodney</u> (Name) <u>Inverness</u> (Address)	<u>clay</u>	<u>12</u>	<u>12</u>
(2) Location: <u>SW 1/4, SW 1/4, Sec. 7 T15R5E</u> <u>4</u> miles <u>SW</u> , of <u>West</u> (distance) (direction) (Nearest Town)	<u>sand</u>	<u>88</u>	<u>100</u>
(3) Topography: <u>Hilly</u> (Hilly) (Flat) (Level)			
(4) Purpose of Well: <u>Diamantine</u> (Domestic Irrigation Municipal, Industrial, Other)			

CODED

Information upon completion of well:

- (1) Diameter 4 inches.
- (2) Total Depth 100 feet.
- (3) Water Level 83 feet below top of ground.
- (4) Cased to 94, Size 4.
- (5) Screen: Size 4, Length 6.
- (6) Were any formations sealed against pollution?
_____ yes, _____ no.
- If YES depth of formation _____
- Why _____
- Drillers Remarks: _____

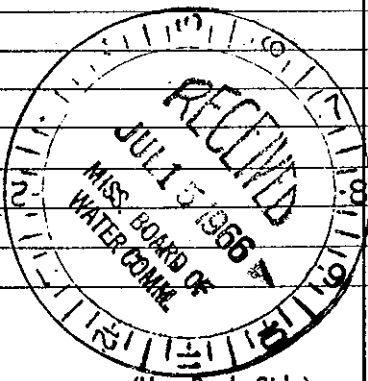

(Use Back Side)

Well No.