

HOLMES
F 42
4-68

MISSISSIPPI
BOARD OF WATER COMMISSIONERS
416 North State Street
Jackson, Mississippi 39201

WATER WELL DRILLERS LOG CODED

4-16-1968 date well completed
Smith Forge & Welding firm name
Holmes county well located

LANDOWNER: Tillie Lamerson

description of formations encountered

from to

West Miss
(mailing address)

WELL LOCATION:


sec. 4 T. 15 N. R. 5 E.
5 E $\frac{1}{4}$ S. NE $\frac{1}{4}$ W
1/2 miles S of West
(distance) (direction) (nearest town)

WELL PURPOSE: Home
(home, irrigation, municipal, industrial)

WELL COMPLETION DATA:

- (1) diameter (inches) 2"
- (2) total depth (feet) 115
- (3) static water level (feet) 0 below above top of ground.
- (4) casing 2" galv. (material), 105 (depth)
2" (size) if telescope see back. CODED
- (5) screen 6' (length), (depth to top)
1/4" (size), Brass (material)
- (6) pump hand (HP), (yield gpm)
man (type power)
- (7) electric log NO (yes or no)
(organization running log)
- (8) how well bottom plugged

red clay 18 18
gray sand 7 25
hard rock 1 26
hard black clay 28 54
white hard rock 2 56
streak of white clay and rock 3 59
gray sand white clay mixture 12 71
white clay and thin layers of rock 10 81
white clay gray sand mixture 11 82
light blue sand 23 119

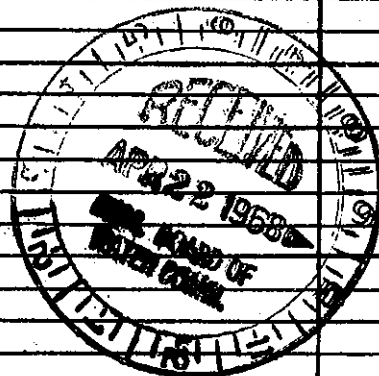

DRILLERS REMARKS: