

HOLMES MISSISSIPPI BOARD OF WATER COMMISSIONERS .


F 2000

12-12-63

WATER WELL DRILLERS LOG

Date: 12/14, 1963, Driller: Frank Dilling ^{Sec. Holmes} County: Franklin
(Name)

		Description & Color of Materials Sand, Clay, Red Clay, Shell, etc.	Thick- ness Feet	Depth Feet
(1) Owner of Land: <u>W.C. Strouss</u> (Name)		Clay + Rock	0	10
<u>Durant Miss</u> (Address)		Chalky clay		40
(2) Location: <u>1/4</u> , <u>1/4</u> , Sec. <u>T10R8E</u>		Sand		76
<u>3</u> miles <u>East</u> of <u>Durant</u> (distance) (direction) (Nearest Town)		Rock		81
(3) Topography: <input checked="" type="checkbox"/> (Hilly) <input type="checkbox"/> (Flat) <input type="checkbox"/> (Level)		Quartz & silt sand		131
(4) Purpose of Well: <u>Home</u> (Domestic Irrigation Municipal, Industrial, Other)		Shale + Stls Rock		143
		Hard Shale		205
		Shale		241
		Rock		247
		Hard Shale		264
		Rock		266
		Shale + Rock		282
		Sand + Clay		287
		Clay + Stls Sand		300
		Clay + Rock		307
		Fine Sand		327
		Rock		333
		Sand + Stls Rock		347
		Shale + Stls Rock		357
		Rock		380
		Shale + Stls Sand		390
		Shale		410
		Rock		472
		Rock + Stls Shale		507
		Fine Sand + Stls Clay		512
		Shale		573
		Fine Sand + Stls Shale		614
		Hard Shale		680
Information upon completion of well:				
(1) Diameter <u>2</u> inches.				
(2) Total Depth <u>680</u> feet.				
(3) Water Level <u>22</u> feet below top of ground.				
(4) Cased to <u>665</u> , Size <u>2"</u>				
(5) Screen: Size <u>1/2"</u> , Length <u>15ft.</u>				
(6) Were any formations sealed against pollution? <input checked="" type="checkbox"/> yes, <input type="checkbox"/> no.				
If YES depth of formation				
Why				
Drillers Remarks:				

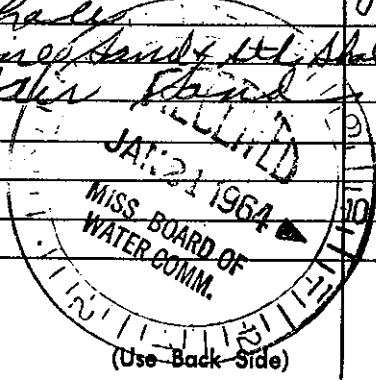

Well No.

Mail this copy to Board of Water Commissioners 429 Miss. St. Jackson, Miss.