


HOLMES
WATER WELL DRILLERS LOG

G3
Date: July 8, 1965, Driller: DELTA DRILLING Co County HOLMES
E Log #36 (Name)

(1) Owner of Land: <u>H.L. NICHOLS, JR.</u> (Name)	Description & Color of Materials Sand, Clay, Red Clay, Shell, etc.	Thick- ness Feet	Depth Feet
<u>TCHULA, MISS</u> (Address)	GUMBO	23	23
(2) Location: <u>SW CORNE 1/4, NE 1/4, Sec. 24 T16 R1W</u> _____ miles _____, of _____ (distance) (direction) (Nearest Town)	SAND	62	85
(3) Topography: _____ (Hilly) (Flat) (Level)	GRAVEL	75	160
(4) Purpose of Well: <u>DOMESTIC</u> (Domestic Irrigation Municipal, Industrial, Other)	GUMBO	66	226
Information upon completion of well:	SAND	164	390
(1) Diameter <u>3</u> inches.	SHALE	49	439
(2) Total Depth <u>1366</u> feet.	SAND	42	481
(3) Water Level <u>FLOWS</u> feet below top of ground.	GUMBO	124	605
(4) Cased to <u>1346</u> , Size <u>3+2"</u>	SHALE	64	669
(5) Screen: Size <u>2"</u> , Length <u>20</u>	GUMBO	97	766
(6) Were any formations sealed against pollution? _____ yes, _____ no.	SHALE	20	786
If YES depth of formation _____	GREEN SAND W/ROCK	40	826
Why _____	SHALE	40	866
Drillers Remarks: <u>23' LAP OF 2"</u>	SAND	60	926
<u>IN 3" PIPE.</u>	SHALE W/ROCK	60	986
	GUMBO	40	1026
	SHALE	40	1066
	SAND	40	1106
	SHALE	20	1126
	GREEN SAND	20	1146
	GUMBO	60	1206
	FINE SAND	75	1281
	SHALE	64	1345
	GUMBO	21	1366

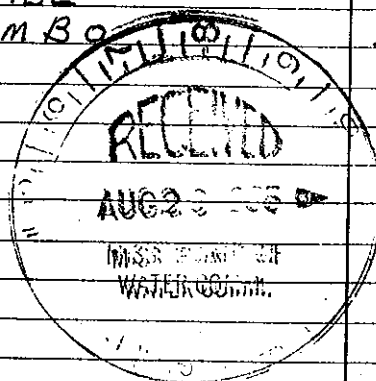

Well No.

(Use Back Side)

Mail this copy to Board of Water Commissioners 429 Miss. St. Jackson, Miss