

HOLMES MISSISSIPPI BOARD OF WATER COMMISSIONERS

G 7
12-2-63

WATER WELL DRILLERS LOG

CODED

Date: 12/2, 1963, Driller: Palmyra Drilling Co. County: Washington
(Name) HOLMES

(1) Owner of Land: E J Hines
(Name)
Tchula, Miss.
(Address) 2829 1st W -
5233 Tchula

(2) Location: 7 miles N.W. of Tchula
(distance) (direction) (Nearest Town)

(3) Topography: Flat
(Hilly) (Flat) (Level)

(4) Purpose of Well: Domestic
(Domestic Irrigation
Municipal, Industrial, Other)

Description & Color of Materials Sand, Clay, Red Clay, Shell, etc.	Thick- ness Feet	Depth Feet
Mud		30
Sand		80
Gravel		156
Mud		340
Sand		385
Mud		500
Sand		610
Mud		732
Rock		734
Mud		971
Green Sand + Mud		1011
Mud		1115
Sand		1153
Rock		1154
Mud		1172
Green Sand		1191
Mud		1202
Light Green sand		1219
Mud		1249
Sand	20	1269
Mud	5	1274
Sand	14	1288

Information upon completion of well:

(1) Diameter: 4 x 3 x 2 1/2 inches.

(2) Total Depth: 1288 feet.

(3) Water Level: 70 feet above ground.

(4) Cased to: all way, Size: 4 x 3 x 2 1/2

(5) Screen: Size: 2 1/2, Length: 30


(6) Were any formations sealed against pollution?
_____ yes, X no.

If YES depth of formation _____

Why _____

Drillers Remarks: _____

CODED

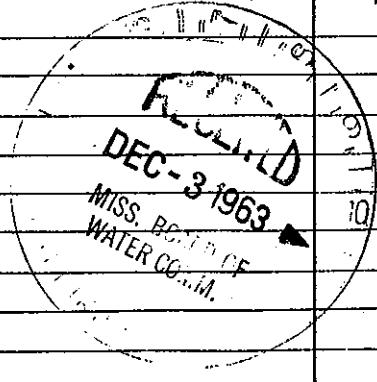

Well No.

(Use Back Side)

Mail this copy to Board of Water Commissioners 429 Miss. St. Jackson, Miss