

HOLMES

MISSISSIPPI BOARD OF WATER COMMISSIONERS

H #2

3-26-62

WATER WELL DRILLERS LOG CODED


037

Date: MAR 26, 1962, Driller: DELTA DRILLING Co. County HOLMES

(Name)

		Description & Color of Materials Sand, Clay, Red Clay, Shell, etc.	Thick- ness Feet	Depth Feet
(1) Owner of Land: <u>GUY P. SHARPE</u> (Name)		TOP SOIL & SAND	62	62
<u>TCHULA, MISSISSIPPI</u> (Address)		GRAVEL	74	136
(2) Location: <u>SW 1/4, SE 1/4, Sec. 31 T6N R10E</u>		SAND w/4" ROCK	43	179
<u>1 1/2</u> miles <u>NORTH</u> , of <u>TCHULA</u> (distance) (direction) (Nearest Town)		GUMBO w/3" ROCK	113	292
(3) Topography: <u>CODED</u> (Hilly) (Flat) (Level)		SHALE	46	338
(4) Purpose of Well: <u>DOMESTIC</u> (Domestic Irrigation Municipal, Industrial, Other)		GUMBO w/4+6" ROCKS	82	420
		SAND	64	484
		SHALE	22	506
		SAND	32	538
		SHALE	97	635
		GUMBO	26	661
Information upon completion of well:		SHALE w/2" ROCK	54	715
(1) Diameter: <u>4</u> inches.		GUMBO w/4" ROCK	53	768
(2) Total Depth: <u>1326</u> feet.		SHALE w/6" ROCK	50	818
(3) Water Level: <u>WELL FLOWS</u> feet below top of ground.		GREEN SAND	100	918
(4) Cased to _____, Size <u>4 x 2 1/2</u>		SHALE	20	938
(5) Screen: Size <u>2 1/2</u> , Length <u>30</u>		GUMBO	10	948
(6) Were any formations sealed against pollution? _____ yes, <input checked="" type="checkbox"/> no. <u>CODED</u>		SHALE	40	988
If YES depth of formation _____		GUMBO	18	1006
Why _____		SAND	12	1018
Drillers Remarks: <u>16' LAP OF 2 1/2"</u>		SHALE	31	1049
<u>PIPE IN 4" PIPE.</u>		GREEN SAND	16	1065
		SHALE w/3" ROCK	57	1116
		SAND w/6" ROCK	38	1154
		SHALE	36	1190
		GUMBO	6	1196
		SHALE	20	1216
		GREEN SAND	22	1238
		SHALE	17	1255
		WHITE SAND	53	1308
		SHALE	18	1326

13

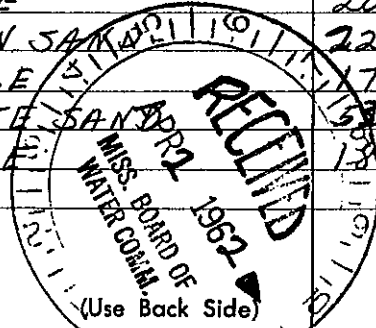

Well No.

Mail this copy to Board of Water Commissioners 429 Miss. St. Jackson, M.