

HOLMES MISSISSIPPI BOARD OF WATER COMMISSIONERS

H 10
10-60

WATER WELL DRILLERS LOG CODED

Date: Oct, 1960, Driller: Jack Martin County Holmes

(Name)

(1) Owner of Land: <u>Wendell Brooks</u> (Name)	Description & Color of Materials Sand, Clay, Red Clay, Shell, etc.	Thick- ness Feet	Depth Feet
(Address)	<u>clay</u>	<u>27</u>	<u>27</u>
(2) Location: <u>NW 1/4, SE 1/4, Sec. 25 T16 R1E</u>	<u>Sand</u>	<u>43</u>	<u>70</u>
<u>7</u> miles <u>E</u> of <u>Thula</u> (distance) (direction) (Nearest Town)	<u>Gravel + Sand</u>	<u>18</u>	<u>88</u>
(3) Topography: <u>Hilly</u> (Hilly) (Flat) (Level)	<u>Sand</u>	<u>62</u>	<u>150</u>
(4) Purpose of Well: <u>Domestic</u> (Domestic Irrigation Municipal, Industrial, Other)	<u>Mud</u>	<u>10</u>	<u>160</u>
	<u>Sand</u>	<u>6</u>	<u>166</u>
	<u>Mud</u>	<u>12</u>	<u>178</u>

CODED


Information upon completion of well:

- (1) Diameter 2 inches.
- (2) Total Depth 165 feet.
- (3) Water Level 150 feet below top of ground.
- (4) Cased to 160, Size 2
- (5) Screen: Size 2", Length 5ft
- (6) Were any formations sealed against pollution?
_____ yes, no.

If YES depth of formation _____

Why _____

Drillers Remarks: _____

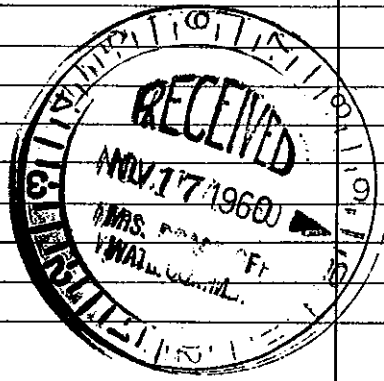

Well No.

(Use Back Side)

Mail this copy to Board of Water Commissioners 429 Miss. St. Jackson, Miss.