

HOLMES MISSISSIPPI BOARD OF WATER COMMISSIONERS

H 301
10-60

H 301

WATER WELL DRILLERS LOG CODED

Date: Oct, 19 60 Driller: Jack Martin County Holmes
(Name)

(1) Owner of Land: George M. Gee
(Name)
Lexington
(Address)

(2) Location: SW 1/4, SE 1/4, Sec. 25 T16 R1E
7 miles E, of Tchula
(distance) (direction) (Nearest Town)

(3) Topography: Hilly
(Hilly) (Flat) (Level)

(4) Purpose of Well: Domestic
(Domestic Irrigation
Municipal, Industrial, Other)

Description & Color of Materials Sand, Clay, Red Clay, Shell, etc.	Thick- ness Feet	Depth Feet
<u>Clay</u>	<u>29</u>	<u>29</u>
<u>Sand & Gravel</u>	<u>7</u>	<u>36</u>
<u>Sand</u>	<u>38</u>	<u>74</u>
<u>Sand & Gravel</u>	<u>17</u>	<u>91</u>
<u>Sand - clay</u>	<u>29</u>	<u>120</u>
<u>Sand</u>	<u>65</u>	<u>185</u>

Information upon completion of well:

(1) Diameter 2 inches.

(2) Total Depth 185 feet.

(3) Water Level 121 feet below top of ground.

(4) Cased to 180, Size 2"

(5) Screen: Size 2", Length 5'


(6) Were any formations sealed against pollution?
_____yes, no.

If YES depth of formation _____

Why _____

Drillers Remarks: _____

CODED

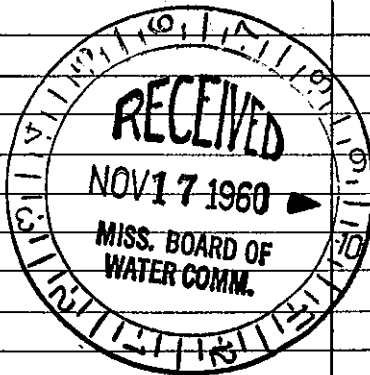

Well No.

(Use Back Side)

Mail this copy to Board of Water Commissioners 429 Miss. St. Jackson, Miss.