

HOLMES MISSISSIPPI BOARD OF WATER COMMISSIONERS

K 26 WATER WELL DRILLERS LOG K 300

7-29-61  
 Date: 7/29, 1961, Driller: Bailey Drilling Co. (Name) County: HOLMES Washington

(1) Owner of Land: Mrs. H. B. McYee (Name) Tekula, Miss. (Address)	Description & Color of Materials Sand, Clay, Red Clay, Shell, etc.	Thick- ness Feet	Depth Feet
	Clay	48	48
	Sand	20	68
	Gravel + Sand	27	95
	Mud	79	174
	Sand	41	215
	Mud + Sand	41	256


(2) Location: 1/4, 1/4, Sec. 5 T4 R4E  
 3 miles 3E, of Tekula  
 (distance) (direction) (Nearest Town)

(3) Topography: Flat  
 (Hilly) (Flat) (Level)

(4) Purpose of Well: Domestic  
 (Domestic Irrigation, Municipal, Industrial, Other)

Information upon completion of well:

- (1) Diameter 2 inches.
  - (2) Total Depth 210 feet.
  - (3) Water Level 106 feet below top of ground.
  - (4) Cased to all way Size \_\_\_\_\_
  - (5) Screen: Size 2, Length 10 ft.
  - (6) Were any formations sealed against pollution?  
 \_\_\_\_\_ yes,  no.
- If YES depth of formation \_\_\_\_\_
- Why \_\_\_\_\_
- Drillers Remarks: \_\_\_\_\_

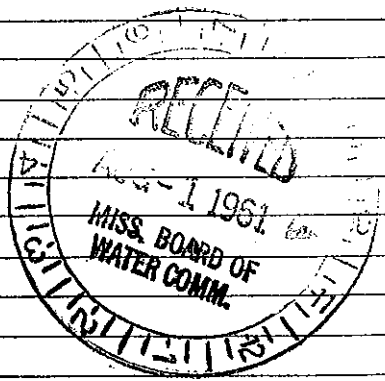

Well No.

(Use Back Side)