

Holmes
K13
11-66

MISSISSIPPI BOARD OF WATER COMMISSIONERS
CODED

WATER WELL DRILLERS LOG

Date: Nov, 1966, Driller: Jack Martin County Holmes
(When well drilled) (Name) (Where well is located)

(1) Owner of Land:	Description & Color of Materials Sand, Clay, Red Clay, Shell, etc.	Thick- ness Feet	Depth Feet
<u>Jimmy Goodman</u> (Name)	<u>Clay</u>	<u>24</u>	<u>24</u>
<u>Shelby</u> (Address)	<u>Pipe clay</u>	<u>8</u>	<u>32</u>
(2) Location: <u>SE 1/4, SW 1/4, Sec. 3, T5R12</u>	<u>Sand - Gravel</u>	<u>24</u>	<u>56</u>
<u>6</u> miles <u>W</u> of <u>Lexington</u> (distance) (direction) (Nearest Town)	<u>Sand</u>	<u>8</u>	<u>64</u>
	<u>Mud</u>	<u>110</u>	<u>174</u>
	<u>Sand</u>	<u>15</u>	<u>189</u>
(3) Topography: <u>Hilly</u> (Hilly) (Flat) (Level)			
(4) Purpose of Well: <u>Domestic</u> (Domestic Irrigation Municipal, Industrial, Other)			

CODED

Information upon completion of well:

- (1) Diameter 2 inches.
- (2) Total Depth 189 feet.
- (3) Water Level 44 feet below top of ground.
- (4) Cased to 181, Size 2
- (5) Screen: Size 2, Length 8
- (6) Were any formations sealed against pollution?
no

If YES depth of formation _____


Why _____

Drillers Remarks: _____

Yield in gpm: 11

Size pump: 3/4 HP

Type power: Electric

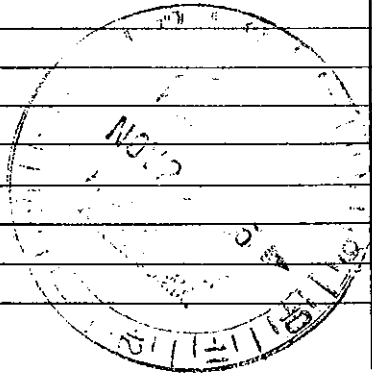

Mail this copy to Board of Water Commissioners 429 Miss. St. Jackson, Miss.