

Holmes
K 14
3-67

MISSISSIPPI
BOARD OF WATER COMMISSIONERS
416 North State Street
Jackson, Mississippi 39201

WATER WELL DRILLERS LOG


3-29-67 date well completed Jack Martin firm name Holmes county well located

LANDOWNER:	Description of formations encountered	from	to
John Quinn Lexington Rt (mailing address)	Clay	0	29
	Pipe Clay & Sand	29	42
	Sand & Gravel	42	92
	Sand - Pipe Clay	92	142
	Sand	142	173

WELL LOCATION:
sec. 15 T. 15 N R. 1 E
6 miles N.W. of Lexington
(distance) (direction) (nearest town)

WELL PURPOSE: Home
(home, irrigation, municipal, industrial)

- WELL COMPLETION DATA:
- (1) diameter (inches) 2
 - (2) total depth (feet) 173
 - (3) static water level (feet) 140 below top of ground.
 - (4) casing Steel, 168 (material), (depth)
2 (size) if telescope see back.
 - (5) screen 5, 168 (length), (depth to top)
2, Stainless Steel (size), (material)
 - (6) pump 3/4, 3 (HP), (yield gpm)
Electric (type power)
 - (7) electric log no (yes or no)
 - (8) how well bottom plugged 2 1/2 Cap

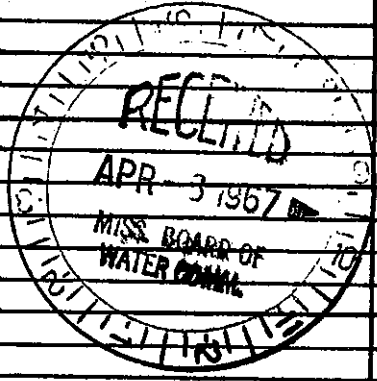

DRILLERS REMARKS: