

HOLMES MISSISSIPPI BOARD OF WATER COMMISSIONERS

L 302

WATER WELL DRILLERS LOG

Date: 3-20-61, 1961, Driller: MCKAY County HOLMES
(Name)

	Description & Color of Materials Sand, Clay, Red Clay, Shell, etc.	Thick- ness Feet	Depth Feet
(1) Owner of Land: <u>MR JOHNSON</u> <small>(Name)</small>	<u>Yellow clay</u>	<u>0</u>	<u>21</u>
<u>LEXINGTON MISS</u> <small>(Address)</small>	" "	<u>21</u>	<u>42</u>
(2) Location: <u>1/4</u> , <u>1/4</u> , Sec. <u>T15R2E</u>	<u>White clay - SAND</u>	<u>42</u>	<u>63</u>
<u>3</u> miles <u>W</u> , of <u>Lexington</u> <small>(distance) (direction) (Nearest Town)</small>	" "	<u>84</u>	<u>105</u>
(3) Topography: <input checked="" type="checkbox"/> (Hilly) <input type="checkbox"/> (Flat) <input type="checkbox"/> (Level)	<u>SHIVIE SAND</u>	<u>105</u>	<u>126</u>
(4) Purpose of Well: <u>Home</u> <small>(Domestic Irrigation Municipal, Industrial, Other)</small>	<u>MED SAND</u>	<u>126</u>	<u>147</u>
	<u>MED " TO Coarse</u>	<u>147</u>	<u>168</u>
	<u>SAND Shiny</u>	<u>168</u>	<u>189</u>
	" "	<u>189</u>	<u>200</u>
	<u>Black SAND clay</u>	<u>200</u>	<u>210</u>

Information upon completion of well:

- (1) Diameter 2 inches.
- (2) Total Depth 200 feet.
- (3) Water Level 80 feet below top of ground.
- (4) Cased to _____, Size _____
- (5) Screen: Size 006, Length 10
- (6) Were any formations sealed against pollution?
 yes, no.


Set screen 158 ft

1/2 HP Rod Pump

If YES depth of formation _____

Why _____

Drillers Remarks: _____

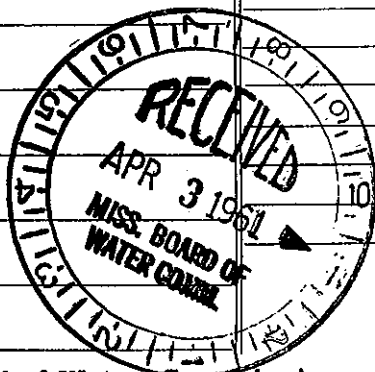

(Use Back Side)

Well No. _____