

HOLMES MISSISSIPPI BOARD OF WATER COMMISSIONERS

L


WATER WELL DRILLERS LOG 2-306

12-4-61

Date: Dec 4, 1961, Driller: McKay Drilling County: Holmes

(Name)

	Description & Color of Materials Sand, Clay, Red Clay, Shell, etc.	Thick- ness Feet	Depth Feet
(1) Owner of Land: <u>Charla Elliott</u> (Name) <u>Serrington Miss</u> (Address)			
(2) Location: <u>1/4, 1/4, Sec. T R</u> <u>3</u> miles <u>W</u> of <u>Serrington</u> (distance) (direction) (Nearest Town)			
(3) Topography: <input checked="" type="checkbox"/> (Hilly) <input type="checkbox"/> (Flat) <input type="checkbox"/> (Level)			
(4) Purpose of Well: <u>Home</u> (Domestic Irrigation Municipal, Industrial, Other)			
Information upon completion of well:			
(1) Diameter <u>2</u> inches.			
(2) Total Depth <u>105</u> feet.			
(3) Water Level <u>55</u> feet below top of ground.			
(4) Cased to _____, Size _____.			
(5) Screen: Size _____, Length _____.			
(6) Were any formations sealed against pollution? _____ yes, _____ no.			
If YES depth of formation _____.			
Why _____.			
Drillers Remarks: _____			

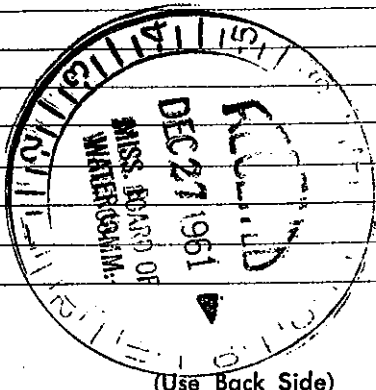

(Use Back Side)

Well No.

Mail this copy to Board of Water Commissioners 429 Miss. St. Jackson, Miss