

L 14

10-6-60

WATER WELL DRILLERS LOG **CODED**

Date: 10/6, 1960, Driller: Pailey Drilling Co County: Washington
 (Name)

(1) Owner of Land: Earl Barton
 (Name)
Lexington, Miss.
 (Address)

(2) Location: 1/4, 1/4, Sec. 26 T. 15 R. 2E
2 miles NW of Lexington
 (distance) (direction) (Nearest town)

(3) Topography: Hilly
 (Hilly) (Flat) (Level)

(4) Purpose of Well: Domestic
 (Domestic Irrigation
 Municipal, Industrial, Other)

Description & Color of Materials Sand, Clay, Red Clay, Shell, etc.	Thick- ness Feet	Depth Feet
Clay	22	22
Sand & gravel	153	175
Mud	280	455
Sand & Mud	41	500
Sand	100	600
Mud	85	685
Mud, green sand & rock	80	765
Green Sand	32	797
Mud	4	801
Light green sand	39	840
Gray Sand	50	890
Mud	17	907
Sand	27	934
Mud	33	967
Rocks, sand & mud	133	1100
Sand	16	1116
Mud	14	1130
Sand	42	1172
Hard mud	3	1175
Sand	6	1181
Mud	19	1200
Sand	21	1221
Mud	19	1240

Information upon completion of well:

(1) Diameter 4 X 2 inches.

(2) Total Depth 1221 feet.

(3) Water Level 58 feet below top of ground.

(4) Cased to bottom, Size _____


(5) Screen: Size 2, Length 20

(6) Were any formations sealed against pollution?
 _____ yes, X no.

If YES depth of formation _____

Why _____

Drillers Remarks: _____

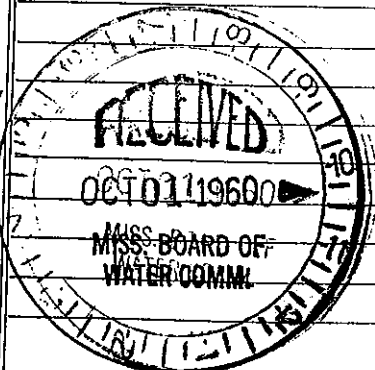

(Use Back Side)

Well No.