

MISSISSIPPI BOARD OF WATER COMMISSIONERS

HOLMES

L15

11-28-60

WATER WELL DRILLERS LOG


CODED

HOLMES

Date: 11/28, 1960, Driller: Bailey Drilling Co County: Washington
(Name)

	Description & Color of Materials Sand, Clay, Red Clay, Shell, etc.	Thick- ness Feet	Depth Feet
(1) Owner of Land: <u>Paul Weems</u> <small>(Name)</small> <u>Lexington, Miss.</u> <small>(Address)</small>	Clay	30	30
(2) Location: <u>1/4</u> , <u>1/4</u> , Sec. <u>16</u> T. <u>15</u> R. <u>58</u> <u>5</u> miles <u>west</u> of <u>Lexington</u> <small>(distance) (direction) (Nearest town)</small>	Sand + gravel	150	180
(3) Topography: <u>Hilly</u> <small>(Hilly) (Flat) (Level)</small>	Mud	320	500
(4) Purpose of Well: <u>Domestic</u> <small>(Domestic Irrigation Municipal, Industrial, Other)</small>	Sand	146	646
Information upon completion of well:	Mud	24	670
(1) Diameter <u>4</u> inches.	Sand	57	727
(2) Total Depth <u>1385</u> feet.	Mud + little sand	205	932
(3) Water Level <u>108</u> feet below top of ground.	Green sand	41	973
(4) Cased to <u>bottom</u> , Size <u>4" x 2 1/2" x 2"</u>	Mud	10	983
(5) Screen: Size <u>2"</u> , Length <u>20ft</u>	Sand	31	1014
(6) Were any formations sealed against pollution? _____ yes, <u>X</u> no.	Mud	40	1054
If YES depth of formation _____	Sand	23	1077
Why _____	Mud	101	1178
Drillers Remarks: _____	Sand	10	1188
	Mud + Sand	167	1355
	Sand	30	1385

CODED

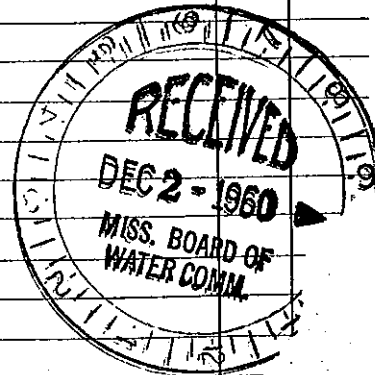

(Use Back Side)

Mail this copy to Board of Water Commissioners 429 Miss. St. Jac