

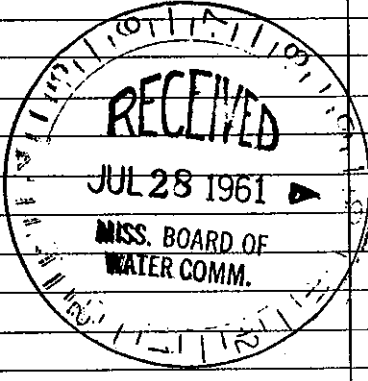
HOLMES MISSISSIPPI BOARD OF WATER COMMISSIONERS

L116
6-29-61

WATER WELL DRILLERS LOG

³⁰¹¹
CODED

Date: 6-29-61, 1961, Driller: DELTA DRILLING Co. County LEFLORE
(Name)

	Description & Color of Materials Sand, Clay, Red Clay, Shell, etc.	Thick- ness Feet	Depth Feet
(1) Owner of Land: <u>MRS. J. W. GUNTER SR</u> <u>907 PECAN</u> (Name) <u>CLARKSDALE,</u> <u>WELL-DRILLED IN -</u> ^{MISS} <u>HOLMES COUNTY</u> (Address)	<u>CLAY</u>	<u>43</u>	<u>43</u>
(2) Location: <u>1/4</u> , <u>1/4</u> , Sec. <u>22 T15R2E</u>	<u>GRAVEL</u>	<u>58</u>	<u>101</u>
<u>2 1/2</u> miles <u>N.W.</u> , of <u>LEXINGTON</u> (distance) (direction) (Nearest Town)	<u>CLAY</u>	<u>3</u>	<u>104</u>
(3) Topography: _____ (Hilly) (Flat) (Level)	<u>SAND</u>	<u>63</u>	<u>167</u>
(4) Purpose of Well: <u>DOMESTIC</u> (Domestic Irrigation Municipal, Industrial, Other)	<u>CLAY</u>	<u>3</u>	<u>170</u>
Information upon completion of well:	<u>SAND</u>	<u>3</u>	<u>202</u>
(1) Diameter <u>2</u> inches.			
(2) Total Depth <u>202</u> feet.			
(3) Water Level _____ feet below top of ground.			
(4) Cased to <u>202</u> , Size <u>2"</u>			
(5) Screen: Size <u>2</u> , Length <u>10'</u>			
(6) Were any formations sealed against pollution? _____ yes, _____ no.			
If YES depth of formation _____	<p style="text-align: center;">CODED</p>		
Why _____			
Drillers Remarks: _____			

(Use Back Side)

Well No.

Mail this copy to Board of Water Commissioners 429 Miss. St. Jackson, Miss.