

Holmes
L 18
6-66

MISSISSIPPI BOARD OF WATER COMMISSIONERS

GW-14779
WATER WELL DRILLERS LOG

CODED

Date: 6-24-1966, Driller: Layne-Central Co. County: Holmes
(Name)

(1) Owner of Land: The Salvation Army
Presbytery of Central
(Name)
Miss.-Lexington, Miss.
(Address)

(2) Location: $\frac{1}{4}$, $\frac{1}{4}$, Sec. 13 T15N R2E
3 miles N of Lex.
(distance) (direction) (Nearest Town)

(3) Topography: _____
(Hilly) (Flat) (Level)

(4) Purpose of Well: Camp and Conference Center
(Domestic Irrigation, Municipal, Industrial, Other)

Description & Color of Materials Sand, Clay, Red Clay, Shell, etc.	Thick- ness Feet	Depth Feet
Top soil	2	2
brown sandy clay	10	12
clay gravel	3	15
sand & clay	5	20
sand & gravel	59	79
clay-sand stks	142	231
sand-clay stks	49	280
sand, lignite-clay stks	60	340
sand-shale	80	420
hard brittle shale	20	440
shale-sand stks	32	472
sand-shale stks	27	499
sand-coarse	55	554
sand-coarse	19	573
shale-sand stks	27	600
sand-clay stks	106	706
hard shale	95	801
rock	7	808
hard shale	65	873
rock-shale stks	6	879
sandy shale	84	963
sand	10	973
shale	61	1034
sand	13	1047
sand	14	1061
shale	32	1093
lime rock-sand stks	20	1113
hard shale	44	1157
hard sand	16	1173
hard sand	7	1180
hard shale	70	1250
shale-stks sand	10	1260
cont'd on back		

Information upon completion of well:

(1) Diameter 9 inches.

(2) Total Depth 1375 feet.

(3) Water Level 92 feet below top of ground.

(4) Cased to 1331', Size 9"


(5) Screen: Size 4", Length 42'

(6) Were any formations sealed against pollution?
 yes, no.

If YES depth of formation 1331'

Why _____ required

Drillers Remarks _____

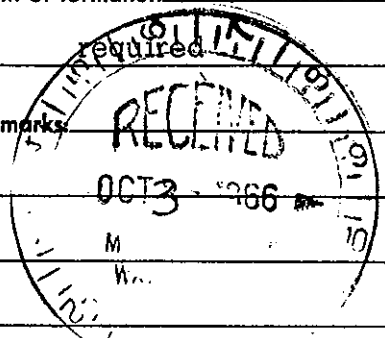

(Use Back Side)

Well No.

Mail this copy to Board of Water Commissioners 429 Miss. St. Jackson, Miss.