

HOLMES MISSISSIPPI BOARD OF WATER COMMISSIONERS

L 23
3-61

WATER WELL DRILLERS LOG

~~CODED SET~~

Date: Mar, 1961, Driller: Jack Martine County: Holmes
(Name)

(1) Owner of Land: J. W. Edwards
(Name)
Lexington, Miss
(Address)

(2) Location: NE 1/4, NE 1/4, Sec. 26 T15 R2E
2 miles NW of Lexington
(distance) (direction) (Nearest Town)

(3) Topography: Hilly
(Hilly) (Flat) (Level)

(4) Purpose of Well: Domestic
(Domestic Irrigation
Municipal, Industrial, Other)

Description & Color of Materials Sand, Clay, Red Clay, Shell, etc.	Thick- ness Feet	Depth Feet
Clay	23	23
Pipe clay + Sand	15	38
Sand	20	58
Sand + Gravel	45	103
Sand	27	130
Sand + Gravel	3	133
Sand	112	245
Mud + Sand	27	272
Fine CODED	30	302
Mud	26	328
Sand	4	332
Mud	10	342
Rock layers + Sand	10	352
Mud	16	368
Sand	6	374
Shale - little Sand	52	426
Mud	36	462
Sand	36	498

Information upon completion of well:

(1) Diameter 2 inches.

(2) Total Depth 495 feet.

(3) Water Level 165 feet below top of ground.

(4) Cased to 480, Size 2


(5) Screen: Size 2, Length 15 ft

(6) Were any formations sealed against pollution?
_____ yes, no.

If YES depth of formation _____

Why _____

Drillers Remarks: _____

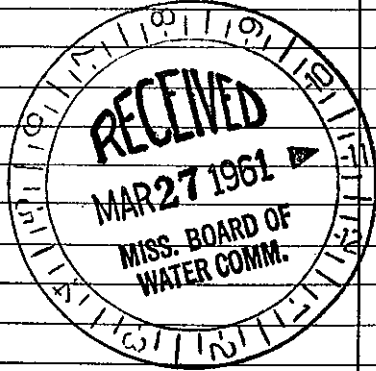

Well No.

(Use Back Side)