

HOLMES
L25

MISSISSIPPI BOARD OF WATER COMMISSIONERS


WATER WELL DRILLERS LOG

CODED ~~2~~

3-61

Date: March, 1961, Driller: Jack Martine County Holmes
(Name)

(1) Owner of Land: <u>Henry C Stewart</u> <small>(Name)</small>	Description & Color of Materials Sand, Clay, Red Clay, Shell, etc.	Thick- ness Feet	Depth Feet
<u>Lexington</u> <small>(Address)</small>	Clay	21	21
(2) Location: <u>SE 1/4, NW 1/4, Sec. 25 T. 48 R. 2 E.</u>	Sand	17	38
<u>2</u> miles <u>North</u> of <u>Lexington</u> <small>(distance) (direction) (Nearest town)</small>	Sand & Gravel Mud	13	51
(3) Topography: <u>Hilly</u> <small>(Hilly) (Flat) (Level)</small>	Sand	7	58
(4) Purpose of Well: <small>(Domestic Irrigation Municipal, Industrial, Other)</small>	Sand-Gravel	10	68
Information upon completion of well:	Sand - Gravel	31	99
(1) Diameter _____ inches.	Sand	7	130
(2) Total Depth <u>376</u> feet.	Mud - Little Sand	42	172
(3) Water Level <u>125</u> feet below top of ground.	Sand	8	180
(4) Cased to <u>366</u> , Size <u>2</u>	SOD - Shale	75	235
(5) Screen: Size <u>2</u> , Length <u>10 ft.</u>	Sand	10	245
(6) Were any formations sealed against pollution? _____ yes, _____ no.	Mud	47	292
If YES depth of formation _____	Sand	5	297
Why _____	Mud	40	337
Drillers Remarks: _____	Sand	43	380

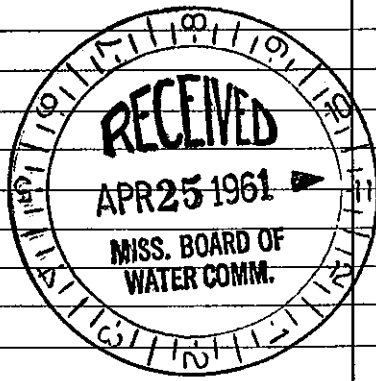

Well No.

(Use Back Side)

Mail this copy to Board of Water Commissioners 429 Miss. St. Jackson, Miss.