


HOLMES MISSISSIPPI BOARD OF WATER COMMISSIONERS

L27  
4-62

WATER WELL DRILLERS LOG **CODED**

Date: April, 1962, Driller: Jack Martin County Holmes  
(Name)

	Description & Color of Materials Sand, Clay, Red Clay, Shell, etc.	Thick- ness Feet	Depth Feet
(1) Owner of Land: <u>W. D. Ford</u> (Name) <u>LEXINGTON MISS</u> (Address)	Top clay	21	21
(2) Location: <u>NW 1/4, SE 1/4, Sec. 25 T16 R2E</u>	Sand Little gravel	19	40
<u>1</u> miles <u>North</u> , of <u>LEXINGTON</u> , (distance) (direction) (Nearest Town)	Sand	5	45
(3) Topography: <u>Hilly</u> (Hilly) (Flat) (Level)	Gravel + sand	36	81
(4) Purpose of Well: <u>Domestic</u> (Domestic Irrigation Municipal, Industrial, Other)	Sand	34	115
Information upon completion of well:	Black mud	6	121
(1) Diameter <u>2</u> inches.	Mud-sand streaks	7	128
(2) Total Depth <u>377</u> feet.	Sand	11	139
(3) Water Level <u>90</u> feet below top of ground.	Mud - <del>fine</del> <b>CODED</b> mud	46	185
(4) Cased to <u>367</u> , Size <u>2</u>	Mud	20	205
(5) Screen: Size <u>2</u> , Length <u>10 ft.</u>	Sand	13	218
(6) Were any formations sealed against pollution? _____ yes, _____ no.	Black mud	59	277
If YES depth of formation _____	Sand	8	285
Why _____	Brown mud	34	319
Drillers Remarks: _____	Sand	58	377
_____			
_____			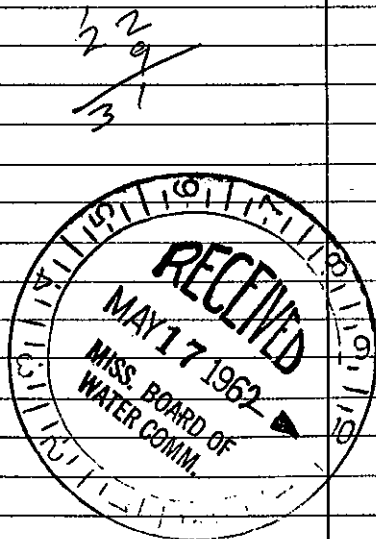
Well No.

(Use Back Side)