

L28  
5-63

WATER WELL DRILLERS LOG


Date: May, 1963, Driller: Jack Martine county Holmes  
(Name)

CODED

(1) Owner of Land:	Description & Color of Materials Sand, Clay, Red Clay, Shell, etc.	Thick- ness Feet	Depth Feet
<u>J. A. McCasley</u> (Name) <u>Lexington</u> (Address)	Top clay	15	15
(2) Location: <u>NE 1/4, SE 1/4, Sec. 22 T15R2E</u> <u>3</u> miles <u>NW</u> of <u>Lexington</u> (distance) (direction) (Nearest Town)	Pipe clay	7	22
(3) Topography: <u>Hilly</u> (Hilly) (Flat) (Level)	Sand	6	28
(4) Purpose of Well: <u>Domestic</u> (Domestic Irrigation Municipal, Industrial, Other)	Sand & gravel	57	85
	Sand CODED	49	134

Information upon completion of well:

- (1) Diameter 2 inches.
- (2) Total Depth 134 feet.
- (3) Water Level 76 feet below top of ground.
- (4) Cased to 129, Size 2.
- (5) Screen: Size 2, Length 5.
- (6) Were any formations sealed against pollution?  
\_\_\_\_\_ yes, \_\_\_\_\_ no.
- If YES depth of formation \_\_\_\_\_
- Why \_\_\_\_\_
- Drillers Remarks: \_\_\_\_\_

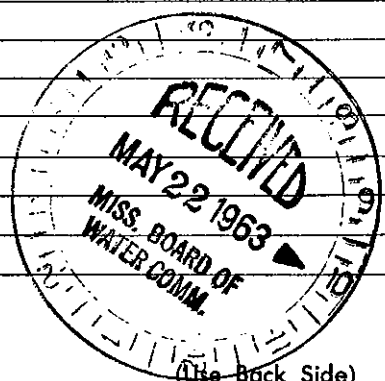

Well No.