

HOLMES
429
10-63


MISSISSIPPI BOARD OF WATER COMMISSIONERS

WATER WELL DRILLERS LOG

CODED 8

Date: Oct, 1963, Driller: Jack Martin County Holmes
(Name)

(1) Owner of Land:	Description & Color of Materials Sand, Clay, Red Clay, Shell, etc.	Thick- ness Feet	Depth Feet
J. A. Burrell (Name)	Clay	5	5
Lexington (Address)	Sand	11	16
(2) Location: SE 1/4, NW 1/4, Sec. 25 T15R2E	Pipe Clay	5	21
1 miles North of Lexington (distance) (direction) (Nearest Town)	Sand	14	35
(3) Topography: Hilly (Hilly) (Flat) (Level)	Sand & Gravel	50	85
(4) Purpose of Well: Domestic (Domestic Irrigation Municipal, Industrial, Other)	Sand	25	110
Information upon completion of well:			
(1) Diameter 2 inches.			
(2) Total Depth 109 feet.			
(3) Water Level 75 feet below top of ground.			
(4) Cased to 104, Size 2			
(5) Screen: Size 2", Length 5'			
(6) Were any formations sealed against pollution?			
_____ yes, _____ no.			
If YES depth of formation _____			
Why _____			
Drillers Remarks: _____			

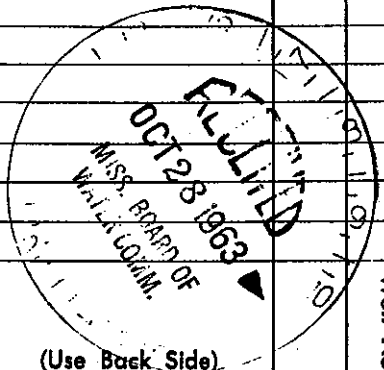

(Use Back Side)

Mail this copy to Board of Water Commissioners 429 Miss. St. Jackson, Miss.