

L 30
11-63


CODED

WATER WELL DRILLERS LOG

Date: Nov., 1963, Driller: Josiah Martin County Holmes
(Name)

(1) Owner of Land: <u>W. E. Thurmond</u> (Name)	Description & Color of Materials Sand, Clay, Red Clay, Shell, etc.	Thick- ness Feet	Depth Feet
<u>Lexington</u> (Address)	<u>Top clay</u>	<u>16</u>	<u>16</u>
(2) Location: <u>NW 1/4, SE 1/4, Sec. 35 T8R2E</u> <u>1/2</u> miles <u>SW</u> of <u>Lexington</u> (distance) (direction) (Nearest Town)	<u>Pipe clay</u>	<u>16</u>	<u>32</u>
(3) Topography: <u>7 lat</u> (Hilly) (Flat) (Level)	<u>Sand</u>	<u>15</u>	<u>47</u>
(4) Purpose of Well: <u>Chicken Farm</u> (Domestic Irrigation Municipal, Industrial, Other)			
Information upon completion of well:			
(1) Diameter <u>2</u> inches.			
(2) Total Depth <u>47</u> feet.			
(3) Water Level <u>35</u> feet below top of ground.			
(4) Cased to <u>42</u> , Size <u>2</u>			
(5) Screen: Size <u>2</u> , Length <u>5</u>			
(6) Were any formations sealed against pollution? _____ yes, _____ no.			
If YES depth of formation _____			
Why _____			
Drillers Remarks: _____			

CODED

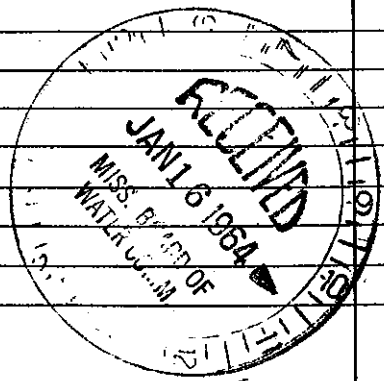

(Use Back Side)

Well No.