

HOLMES
L32
5-65

MISSISSIPPI BOARD OF WATER COMMISSIONERS

WATER WELL DRILLERS LOG

CODED

Date: May, 1965, Driller: Jack Martin County Holmes
(Name)

(1) Owner of Land:	Description & Color of Materials Sand, Clay, Red Clay, Shell, etc.	Thick- ness Feet	Depth Feet
<u>John Swinney</u> (Name) <u>Lexington</u> (Address)	<u>clay</u>	<u>15</u>	<u>15</u>
(2) Location: <u>NW 1/4, NW 1/4, Sec. 28 T15R2E</u> <u>3</u> miles <u>NW</u> , of <u>Lexington</u> (distance) (direction) (Nearest Town)	<u>Sand Gravel</u>	<u>20</u>	<u>35</u>
(3) Topography: <u>Hilly</u> (Hilly) (Flat) (Level)	<u>Pipe clay-sand</u>	<u>63</u>	<u>98</u>
(4) Purpose of Well: <u>Domestic</u> (Domestic Irrigation Municipal, Industrial, Other)	<u>Sand</u> CODED	<u>22</u>	<u>120</u>


Information upon completion of well:

- (1) Diameter 2 inches.
- (2) Total Depth 120 feet.
- (3) Water Level 55 feet below top of ground.
- (4) Cased to 115, Size 2
- (5) Screen: Size 2, Length 5
- (6) Were any formations sealed against pollution?
_____yes, _____no.

If YES depth of formation _____

Why _____

Drillers Remarks: _____

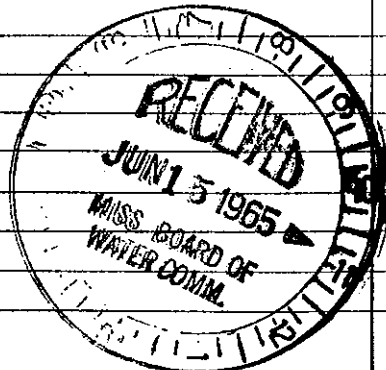

Well No.

(Use Back Side)