

HOLMES
L33

MISSISSIPPI BOARD OF WATER COMMISSIONERS

7-66

WATER WELL DRILLERS LOG **CODED**

Date: July, 1966, Driller: Jack Martin County Holmes
(Name)

(1) Owner of Land:	Description & Color of Materials Sand, Clay, Red Clay, Shell, etc.	Thick- ness Feet	Depth Feet
<u>Acac Wynne</u> (Name) <u>Lexington Rt #2</u> (Address)	<u>clay</u>	<u>22</u>	<u>22</u>
(2) Location: <u>NE 1/4, NW 1/4, Sec. 24 T15R2E,</u> <u>2 miles North</u> of <u>Lexington</u> (distance) (direction) (Nearest Town)	<u>pipe clay</u>	<u>6</u>	<u>28</u>
(3) Topography: <u>Hilly</u> (Hilly) (Flat) (Level)	<u>sand</u>	<u>27</u>	<u>55</u>
(4) Purpose of Well: <u>Domestic</u> (Domestic Irrigation Municipal, Industrial, Other)	<u>Sand & Gravel</u>	<u>30</u>	<u>85</u>
	<u>Sand</u> CODED	<u>37</u>	<u>122</u>


Information upon completion of well:

- (1) Diameter 2 inches.
- (2) Total Depth 122 feet.
- (3) Water Level 96 feet below top of ground.
- (4) Cased to 117, Size 2
- (5) Screen: Size 2, Length 5
- (6) Were any formations sealed against pollution?
_____ yes, no.

If YES depth of formation _____

Why _____

Drillers Remarks: _____

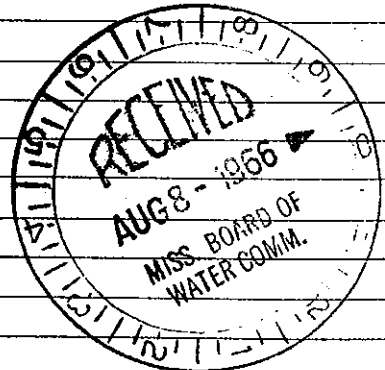

(Use Back Side)

Well No.

Mail this copy to Board of Water Commissioners 429 Miss. St. Jackson, Miss