

HOLMES MISSISSIPPI BOARD OF WATER COMMISSIONERS

M 1

WATER WELL DRILLERS LOG

~~2000~~

4-21-61 CODED

Date: 4-21, 1961, Driller: Jack Martin County Holmes
 Black Creek Charcoal plant (Name)


(1) Owner of Land: H. A. Hyman
 (Name)
 Lexington Miss
 (Address)
 Lot # 1
 (2) Location: 1/4, 1/4, Sec 31 T15R3E
 1 1/2 miles East of Lexington
 (distance) (direction) (Nearest Town)
 (3) Topography: Flat
 (Hilly) (Flat) (Level)
 (4) Purpose of Well: Industrial
 (Domestic Irrigation
 Municipal, Industrial, Other)

Description & Color of Materials Sand, Clay, Red Clay, Shell, etc.	Thick- ness Feet	Depth Feet
Clay	20	20
Sand	9	29
Sand & clay	21	50
Mud	10	60
Sand	2	62
Mud - little Sand	10	72
Sand	4	76
Mud - Sand streaks	27	103
Sand - little Mud	15	118
Mud -	22	140
Sand - Mud streaks	18	158
Mud	38	196
Sand	6	202
Shale - Sand streaks	28	230
Sand	40	270

Information CODED upon completion of well:

(1) Diameter 4 inches.
 (2) Total Depth 269 feet.
 (3) Water Level 1 feet above top of ground.
 (4) Cased to 254, Size 4"
 (5) Screen: Size 4", Length 15 ft
 (6) Were any formations sealed against pollution?
 _____ yes, _____ no.

If YES depth of formation _____
 Why _____
 Drillers Remarks: _____

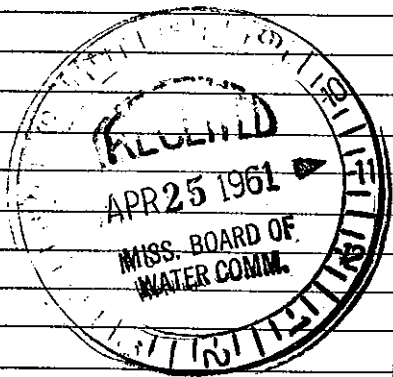

Well No.

(Use Back Side)

Mail this copy to Board of Water Commissioners 429 Miss. St. Jackson, Miss.